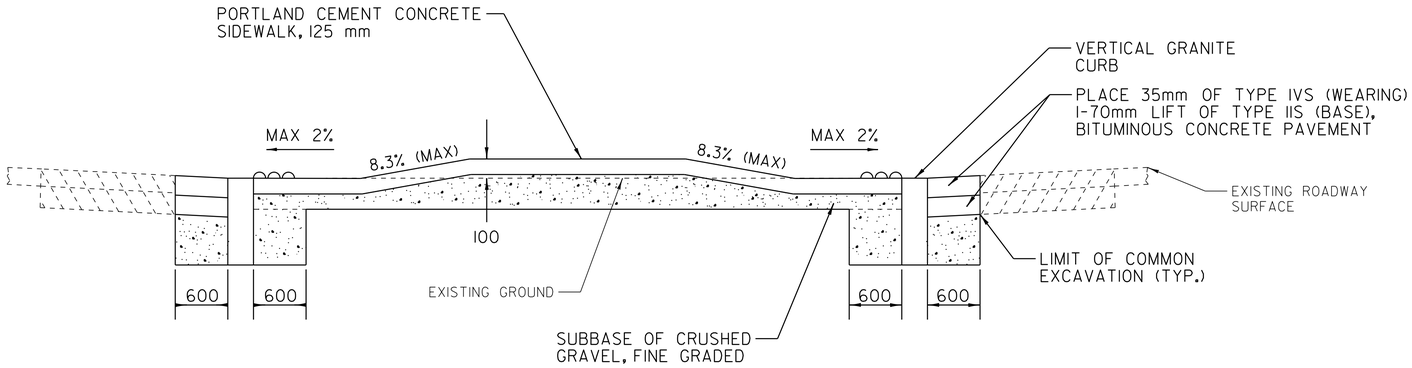

SECTION A – A

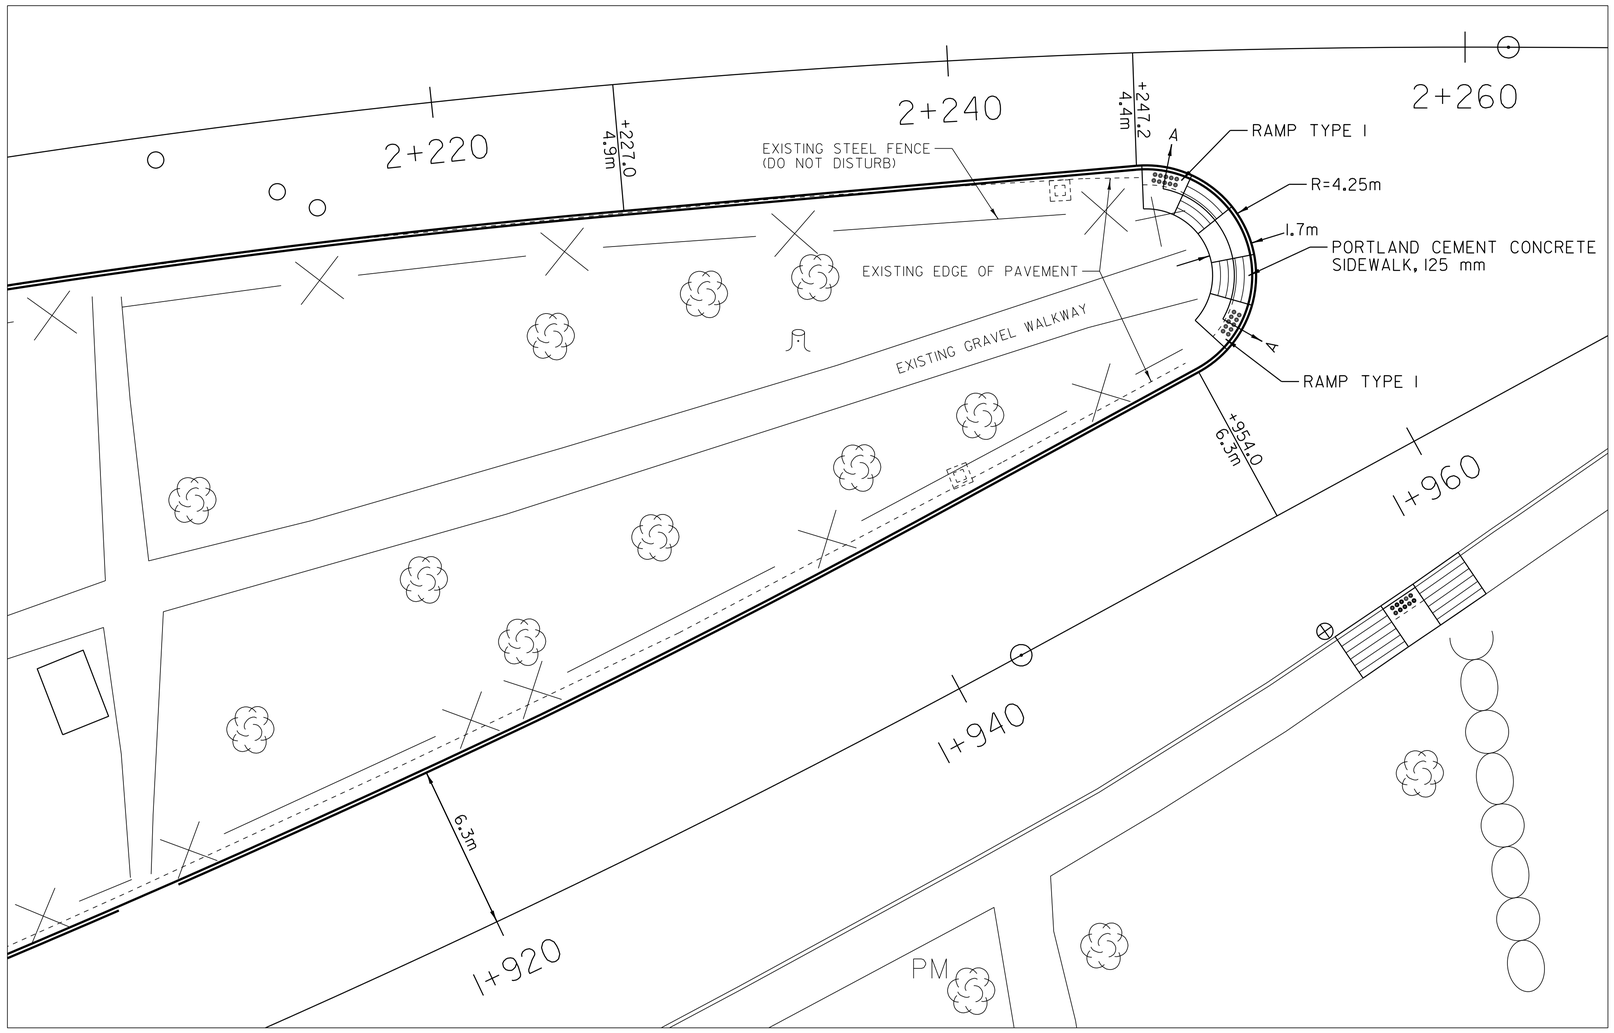

EAST END VILLAGE GREEN

NOT TO SCALE

NOTE: ALL DIMENSIONS IN MILLIMETERS EXCEPT AS INDICATED

VILLAGE GREEN CURB DETAILS 2	PROJECT NAME: WOODSTOCK
	PROJECT NUMBER: NH 2606(1)S
	DESIGN FILE NAME:/pave/06b036/pb036.dgn PLOT DATE: 11-JUN-2012 16:16
	IPARM FILE NAME: pb036dt03.i DRAWN BY: MRS
	PROJECT LEADER: PTS CHECKED BY:NLL
	DESIGNED BY: NLL SHEET 40 OF 73