STATE OF VERMONT
AGENCY OF TRANSPORTATION

TRAFFIC SIGN SUMMARY SHEET 4

VAOT Metric

KILOMETER MARKER, STATION, OR SIGN NUMBER	SIGN LEGEND	SIGN DIMENSIONS EA	WIDTH (mm)	HEIGHT (mm)	NEW & SALVAGED SIGNS "A"	"B"	SALV SIGN	SALV TIS	EXIST POST RETAIN	SALVAGE	NEW SIGN POSTS NO. OF POSTS	FLANGED CHANNEL kg/m 1.7	3.0	4.5	SQUARE STEEL (mm) kg/m 44 3.4	50 3.9	63 5.0	ANCHOR	SLEEVE	TUBULAR ALUMINUM Ø (mm) kg/m 75 1.9	100 2.5	100 MOD 2.5	FOUND-ATION	TUBULAR STEEL Ø (mm) kg/m 75 11.3	89 13.4	100 16.1	125 21.7	W-SHAPE STEEL FTG. SIZE 600 mm	750 mm	WEIGHT	POST SIZE	SIGN FRAME REQUIRED	REMARKS		SIGN DETAIL DETAIL ON SHEET NUMBER	STD. SHEET NUMBER
												OPTION ITEMS																									
STA 1+477 RT		1	750	750	0.56						1			~~4.6~~ 4.27		4.6		X															W11-2	FLUORESCENT YELLOW-GREEN SHEETING		E-152
		1	600	300	0.18																												W16-7P	FLUORESCENT YELLOW-GREEN SHEETING		E-152
STA 1+482 LT		1	REMOVED AT THE REQUEST OF THE TOWN ~~750~~	~~750~~	0.56						1			~~4.6~~ 4.27		4.6		X															W11-2	FLUORESCENT YELLOW-GREEN SHEETING		E-152
		1	REMOVED AT THE REQUEST OF THE TOWN ~~600~~	~~300~~	0.18																												W16-7P	FLUORESCENT YELLOW-GREEN SHEETING		E-152
MOVED TO I+467 RT ~~STA 1+518 LT~~																																					
		1	600	450	0.27						1			~~4.6~~ 3.96		4.6		X															D11-1			
		1	300	225	0.07																												M7-1			
STA 1+543 LT		1	600	750	0.45						1			~~4.6~~ 3.96		4.6		X															R2-1			E-142
~~STA 1+586 RT~~		1 1	600 600	300 300	0.18 0.18						2			4.88 ~~9.6~~ 4.88		9.6		X														2	M4-5 M4-5 (SIGN FRAMES E-123)		E-136B E-136B
MOVED TO STA 1+410 RT	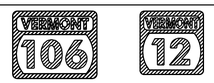	1 1	600 600	300 300	0.18 0.18																												M3-3 M3-1		E-136B E-136B
		1 1	750 600	600 600	0.45 0.36																														E-136B E-136B
		1 1	525 525	375 375	0.20 0.20																												M6-3 M6-3		E-136B E-136B
STA 1+619 RT		1	300	450	0.14						1			3.66 ~~4.6~~		4.6		X															R7-8			
STA 1+630 RT STA 1+644 LT		2	REMOVED AT THE REQUEST OF TOWN ~~750~~	~~750~~	0.56 ~~1.12~~ 0.56						1 1			4.57 ~~4.6~~ ~~4.6~~ 4.57		4.6 4.6		X X															W11-2	FLUORESCENT YELLOW-GREEN SHEETING		E-152
		2	REMOVED AT THE REQUEST OF TOWN ~~600~~	~~300~~	0.18 ~~0.36~~ 0.18																												W16-7P	FLUORESCENT YELLOW-GREEN SHEETING		E-152
												m	m	m 41.8	m	m 41.8	m		EA	kg	kg	kg		kg	kg	kg	kg									
														39.02																							
	TOTALS				m² 5.82	m²	EA.	m²				m ~~41.8~~			m 41.8					kg			EA.	kg				EA.	EA.	kg						

FINAL POST LENGTHS ARE TO BE DETERMINED IN THE FIELD. POST SIZES ARE COMPUTED BASED ON INFORMATION FURNISHED ON THE STANDARD SHEETS AND THE ROADWAY TRAFFIC AND SAFETY SECTION'S "SIGN POST DESIGN GUIDELINE."

TRAFFIC SIGN SUMMARY SHEET 4

PROJECT : WOODSTOCK	PROJECT NO.: NH 2606(1)S
DESIGN FILE NAME: /pave/06b036/pb036.dgn	
IPARM FILE NAME: pb036ts04.i	PLOT DATE: 11-JUN-2012 16:1
SURVEYED BY: CLD ENGINEERS INC	SURVEY DATE: 08-2006
SQUAD LEADER: PTS	DRAWN BY: MRS
CLD 06-0232	SHEET: 45 OF 73