TEMPORARY 100mm WHITE LINE, PAINT
DURABLE 100mm WHITE LINE, THERMOPLASTIC
STA 12+040 TO 12+052 SOLID LT PARKING
STA 12+041 TO 12+053 SOLID RT PARKING
STA 12+052 TO 12+058 SOLID LT NO PARKING
STA 12+054 TO 12+058 SOLID RT NO PARKING
STA 12+061 TO 12+067 SOLID LT NO PARKING
STA 12+061 TO 12+070 SOLID RT NO PARKING
STA 12+067 TO 12+079 SOLID LT PARKING
STA 12+070 TO 12+083 SOLID RT PARKING
STA 12+079 TO 12+080 SOLID LT NO PARKING
STA 12+084 TO 12+087 SOLID RT NO PARKING
STA 12+084 TO 12+086 SOLID LT NO PARKING
STA 12+086 TO 12+092 SOLID LT PARKING
STA 12+090 TO 12+093 SOLID RT NO PARKING
STA 12+092 TO 12+094 SOLID LT NO PARKING
STA 12+093 TO 12+103 SOLID RT PARKING
STA 12+097 TO 12+099 SOLID LT NO PARKING
STA 12+099 TO 12+118 SOLID LT PARKING
STA 12+104 TO 12+108 SOLID RT NO PARKING
STA 12+111 TO 12+114 SOLID RT NO PARKING
STA 12+114 TO 12+153 SOLID RT PARKING
STA 12+118 TO 12+120 SOLID LT NO PARKING
STA 12+124 TO 12+125 SOLID LT NO PARKING
STA 12+125 TO 12+137 SOLID LT PARKING
STA 12+137 TO 13+138 SOLID LT NO PARKING
STA 12+141 TO 12+142 SOLID LT NO PARKING
STA 12+142 TO 12+180 SOLID LT PARKING
STA 12+153 TO 12+156 SOLID RT NO PARKING
STA 12+159 TO 12+160 SOLID RT NO PARKING
STA 12+160 TO 12+172 SOLID RT PARKING
STA 12+172 TO 12+176 SOLID RT NO PARKING
STA 12+176 TO 12+180 SOLID RT PARKING

TEMPORARY 100mm YELLOW LINE, PAINT
DURABLE 100mm YELLOW LINE, THERMOPLASTIC
STA 12+040 TO 12+059 SOLID LT & RT
STA 12+061 TO 12+180 SOLID LT & RT

TEMPORARY LETTER OR SYMBOL, PAINT
DURABLE LETTER OR SYMBOL, TYPE ITAPE
STA 12+041 LT - "ONLY"
STA 12+053 RT - DISABLED MARKING

TEMPORARY CROSSWALK MARKING, PAINT
STA 12+060 LT TO RT

SPECIAL PROVISION (DURABLE
CROSSWALK MARKING, IMPRINTED/COLORIZED)
STA 12+060 LT TO RT

CONSTRUCT SIDEWALK RAMP
W/DETECTABLE WARNING SURFACE (RED)
STA 12+060 LT (CONCRETE PAD)
STA 12+060 RT (CONCRETE PAD)

CHANGING ELEVATION OF DROP INLETS,
CATCH BASINS, OR MANHOLES
STA 12+064 RT (DI) REHAB
STA 12+064 LT (DI)

CHANGING ELEVATION OF DROP INLETS,
CATCH BASINS, OR MANHOLES (BY OTHERS)
STA 12+088 RT (TELEPHONE MH)
STA 12+168 RT (CABLE TV MH)

SPECIAL PROVISION
(REMOVE PARKING METER)
(TO BE RETURNED TO THE TOWN)
STA 12+060 LT
STA 12+063 RT
STA 12+067 RT

CHANGING ELEVATION
OF SEWER MANHOLES
STA 12+040 LT
STA 12+138 LT

ADJUST ELEVATION
OF VALVE BOX — DONE BY TOWN
STA 12+174 RT

REMOVING SIGNS
AS SHOWN - 1

VAOT Metric

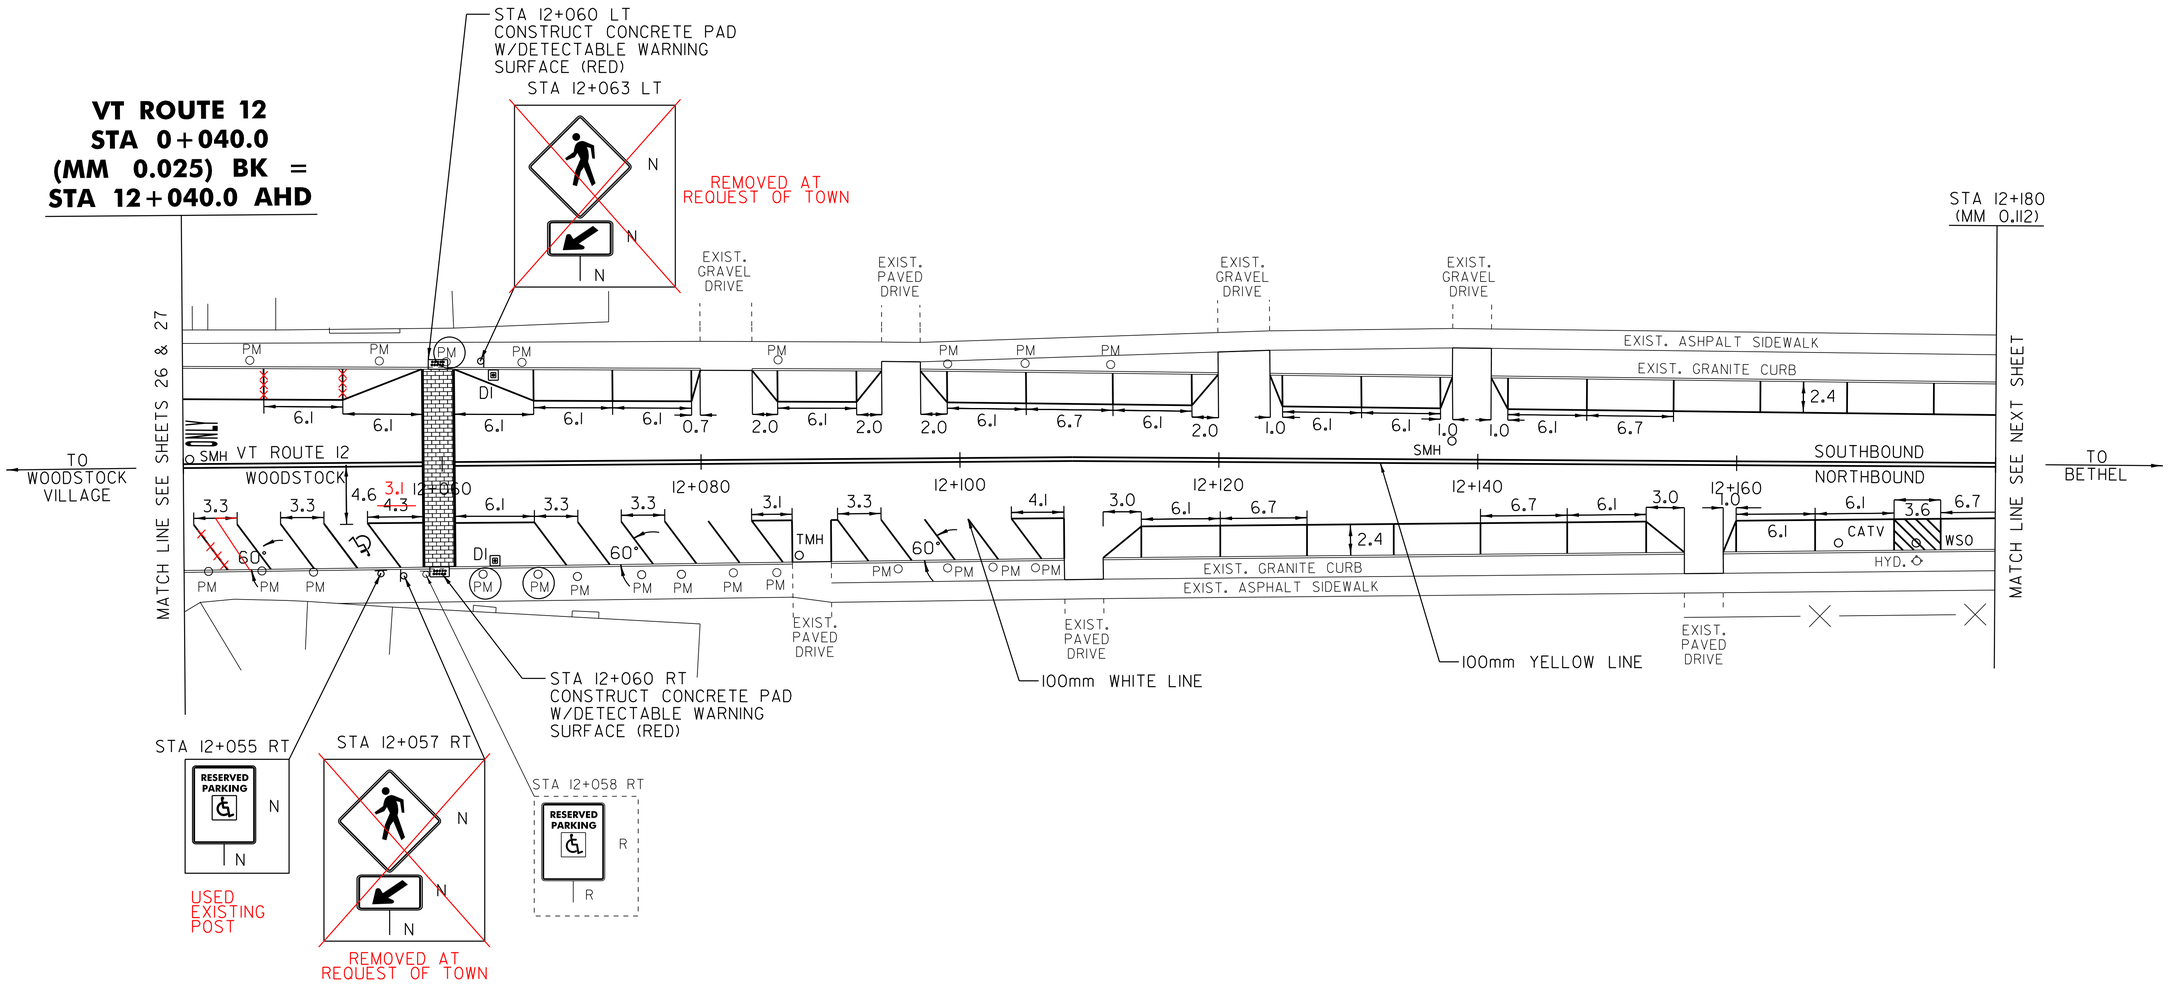

NOT TO SCALE

NOTE: ALL DIMENSIONS IN METERS EXCEPT AS INDICATED

LEGEND

R	=	REMOVE EXISTING
S	=	SALVAGE
R&S	=	REMOVE AND SALVAGE
N	=	NEW
RET	=	RETAIN
B-B	=	BACK TO BACK

PAVING LAYOUT 1

PROJECT NAME: WOODSTOCK
PROJECT NUMBER: STP 2509(I)S

DESIGN FILE NAME:/pave/05c056/pc056.dgn
IPARM FILE NAME: pc056la01.i
PROJECT LEADER: PTS
DESIGNED BY: NLL
PLOT DATE: 11-JUN-2012 16:17
DRAWN BY: MRS
CHECKED BY:NLL
SHEET 62 OF 73