STATE OF VERMONT
AGENCY OF TRANSPORTATION

TRAFFIC SIGN SUMMARY SHEET 4

VAOT Metric

KILOMETER MARKER, STATION, OR SIGN NUMBER	SIGN LEGEND	SIGN DIMENSIONS EA	WIDTH (mm)	HEIGHT (mm)	NEW & SALVAGED SIGNS "A"	"B"	SALV SIGN	SALV TIS	EXIST POST RETAIN	EXIST POST SALVAGE	NEW SIGN POSTS NO. OF POSTS	FLANGED CHANNEL kg/m 1.7	3.0	4.5	SQUARE STEEL (mm) 44 kg/m 3.4	50 kg/m 3.9	63 kg/m 5.0	ANCHOR	SLEEVE	TUBULAR ALUMINUM Ø (mm) 75 kg/m 1.9	100 kg/m 2.5	100 MOD kg/m 2.5	FOUND-ATION	TUBULAR STEEL Ø (mm) 75 kg/m 11.3	89 kg/m 13.4	100 kg/m 16.1	125 kg/m 21.7	W-SHAPE STEEL FTG. SIZE 600 mm	750 mm	WEIGHT	POST SIZE	SIGN FRAME REQUIRED	REMARKS	SIGN DETAIL DETAIL ON SHEET NUMBER	STD. SHEET NUMBER
											OPTION ITEMS																											
STA 12+848 RT	BIKE ROUTE	1	600	450	0.27						1			3.96 ~~4.6~~		4.6		X																	D11-1		
		1	300	225	0.07																													M7-2		
STA 12+855 RT	STOP	1	750	750	0.56						1			3.96 ~~4.6~~		4.6		X																	R1-1		E-143
STA 12+892 RT	STOP	1	750	750	0.56						1			3.96 ~~4.6~~		4.6		X																	R1-1		E-143
					1.46									11.88																						
	SUBTOTALS SHEET 70				5.97		0							~~41.5~~	34.90	41.5			3																	
	SUBTOTALS SHEET 71				3.40		4							~~32.6~~	30.49	32.6																				
	SUBTOTALS SHEET 72				4.86		0							~~32.0~~	25.00	32.0																				
	SUBTOTALS SHEET 73				1.46		0							~~13.8~~	11.88	13.8																				
	ROUNDING				0.31									5.1		5.1																				

= 15.69 m 4 EA 102.27 m

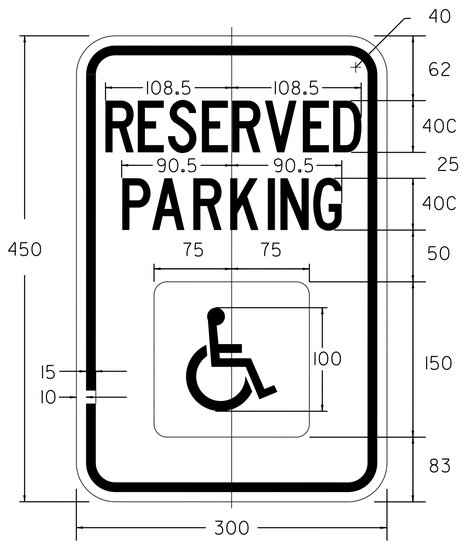

COLORS:

LEGEND AND BORDER-GREEN
WHITE SYMBOL ON BLUE BACKGROUND
BACKGROUND WHITE

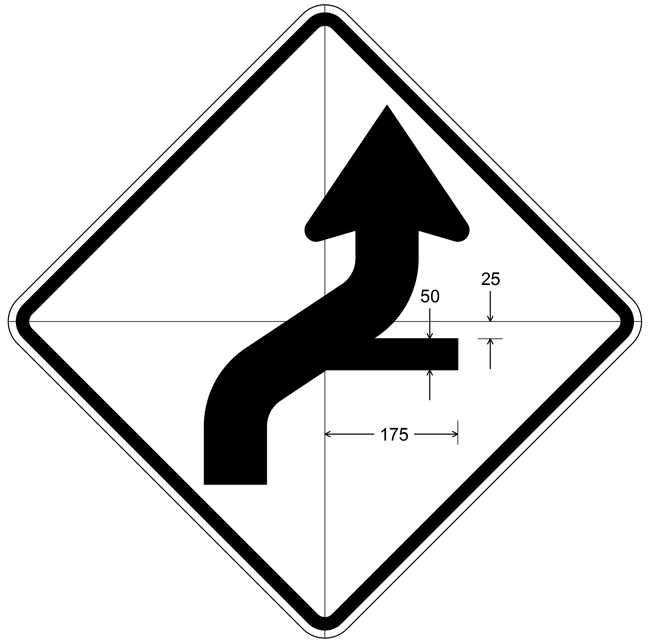

USE WI-4R AS BASE SIGN
SEE STD. E-151 FOR COLORS

IN ACCORDANCE WITH THE VTRANS 2006 STANDARD SPECIFICATIONS FOR CONSTRUCTION, SECTION 675.02 "MATERIALS", ALL NEW SIGNS INSTALLED SHALL BE MARKED ON THE BACK WITH THE FOLLOWING INFORMATION:

	VT 12
TOWN	WOODSTOCK
MONTH AND YEAR OF SIGN FABRICATION	XX/08
ROUTE WHERE SIGN IS INSTALLED	TH3

NOT TO SCALE

NOTE: ALL DIMENSIONS IN MILLIMETERS EXCEPT AS INDICATED

FINAL POST LENGTHS ARE TO BE DETERMINED IN THE FIELD. POST SIZES ARE COMPUTED BASED ON INFORMATION FURNISHED ON THE STANDARD SHEETS AND THE ROADWAY TRAFFIC AND SAFETY SECTION'S "SIGN POST DESIGN GUIDELINE."

								m	m	m	m	m	m		EA	kg	kg	kg		kg	kg	kg	kg												
															3																				
PROJECT TOTALS	m² 16.0	m²	EA. 4	m²			m 125			m 125			kg	EA.	kg			EA.	EA.	kg																

TRAFFIC SIGN SUMMARY SHEET 4

PROJECT :	PROJECT NO. :
WOODSTOCK	STP 2509(I)S

DESIGN FILE NAME: /pave/05c056/pc056.dgn
IPARM FILE NAME: pc056ts04.i PLOT DATE: 11-JUN-2012 16:
SURVEYED BY: CLD ENGINEERS INC SURVEY DATE: 08-2006
SQUAD LEADER: PTS DRAWN BY: MRS
CLD 06-0232 SHEET: 73 OF 73