INDEX OF SHEETS
SEE SHEET 2

STATE OF VERMONT
AGENCY OF TRANSPORTATION

PROPOSED IMPROVEMENT
TOWNS OF MANCHESTER AND DORSET
COUNTY OF BENNINGTON
U.S. ROUTE 7

BEGINNING IN THE TOWN OF MANCHESTER ON U.S. ROUTE 7 AT MILE MARKER 4.616 = STA. 243+72.48 AND EXTENDING NORTHERLY FOR A DISTANCE OF 24,546.72 FEET (4.649 MILES) TO A POINT IN THE TOWN OF DORSET AT MILE MARKER 1.745 = STA. 92+13.60.

LENGTH OF ROADWAY 24,546.72 FT (4.649 MILES)
LENGTH OF PROJECT 24,546.72 FT (4.649 MILES)

WORK TO BE PERFORMED UNDER THIS PROJECT INCLUDES RESURFACING OF THE EXISTING HIGHWAY WITH A SHIM/LEVELING COURSE AND WEARING COURSE NEW PAVEMENT MARKINGS, DRAINAGE IMPROVEMENTS, GUARDRAIL IMPROVEMENTS, RAILROAD GRADE CROSSING IMPROVEMENTS, NEW SIGNS AND INCIDENTAL ITEMS.

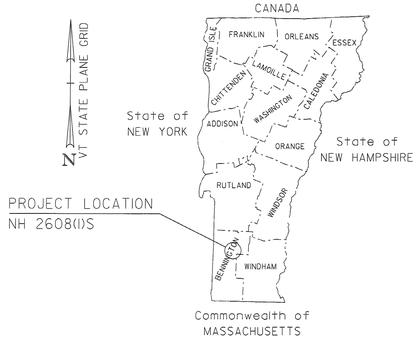

BITUMINOUS CONCRETE PAVEMENT SUPERPAVE MIXTURE DESIGN CRITERIA	
DESIGN LANE/DESIGN LIFE ESALS	1,049,500
DESIGN NUMBER OF GYRATIONS	75
PERFORMANCE GRADED ASPHALT BINDER	58-28

RECORD PLANS

CONTRACTOR: PIKE INDUSTRIES, INC. – BERLIN, VT
RESIDENT ENGINEER: TIM POCKETTE
CONSTRUCTION BEGAN: JULY 23, 2008
CONSTRUCTION COMPLETE: MAY 5, 2009
RECORD PLANS BY: TIM POCKETTE & N. GARBACIK

I HEREBY CERTIFY THAT ALL THE CONSTUCTION REQUIRED BY THIS SET OF DRAWINGS HAS BEEN ACCOMPLISHED AS INDICATED HEREIN.

BY _____ RESIDENT ENGINEER

DATE 11-05-09

NOTE: Any further information concerning final quantities, amounts or other details relative to this project may be found at Central Files in the electronic archives.

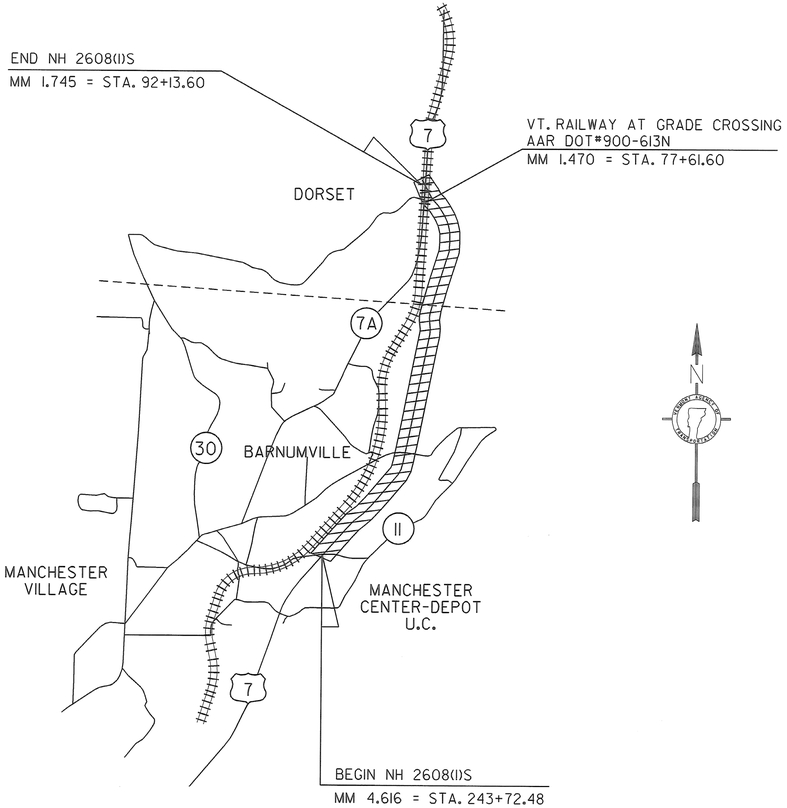

TRAFFIC DATA

LOCATION	ADT 2007	ADT 2017	DHV 2007	DHV 2017	ESALS 2007-2017	ESALS 2007-2017
MANCHESTER - DORSET	3000	3400	340	385	888,000	2,099,000

CONVENTIONAL SYMBOLS

COUNTY LINE
TOWN LINE
LIMITS OF ACCESS
POINT OF ACCESS
FENCE LINE
STONE WALL
TRAVELED WAY
GUARD RAIL
RAILROAD
SURVEY LINE
CULVERT
POWER POLE
TELEPHONE POLE
TREES
CONTROL OF ACCESS
PROPERTY LINE
R.O.W. TAKING LINE
SLOPE RIGHTS (SR SR SR)
TOP OF CUT
TOE OF SLOPE

STATE OF VERMONT · DALE E. GOZALKOWSKI · No. 7227 · REGISTERED PROFESSIONAL ENGINEER

PLANS PREPARED BY

CLOUGH HARBOUR & ASSOCIATES LLP
© 2007
III Winners Circle, PO Box 5269, Albany, NY 12205
Main: (518) 453-4500 • www.cloughharbour.com

BY: Dale E Gozalkowski

SURVEYED BY: NA
SURVEYED DATE: NA

DATUM
VERTICAL: NA
HORIZONTAL: NA

THESE PLANS ARE SUBJECT TO SUCH ENGINEERING CHANGES AS MAY BE REQUIRED BY THE FEDERAL HIGHWAY ADMINISTRATION OR THE DIRECTOR OF PROGRAM DEVELOPMENT.

CONSTRUCTION IS TO BE CARRIED ON IN ACCORDANCE WITH THESE PLANS AND THE STANDARD SPECIFICATIONS FOR CONSTRUCTION DATED 2006, AS APPROVED BY THE FEDERAL HIGHWAY ADMINISTRATION ON JUNE 15, 2006 FOR USE ON THIS PROJECT, INCLUDING ALL SUBSEQUENT REVISIONS AND SUCH REVISED SPECIFICATIONS AND SPECIAL PROVISIONS AS ARE INCORPORATED IN THESE PLANS.

DIRECTOR OF PROGRAM DEVELOPMENT
APPROVED _____ DATE 5-7-08

PROJECT MANAGER : TED DOMEY

PROJECT NAME : MANCHESTER - DORSET
PROJECT NUMBER : NH 2608 (I) S

SHEET 1 OF 78 SHEETS

FILE NAME = u:\13947\MSTN\NH 2608\cover.dgn
DATE/TIME = 9/18/2007
USER = LKSY