



GEOTEXTILE FOR SILT FENCE
 STA. A 1+043.0, 8.5m LT. - STA. A 1+089.0, 11.0m LT.
 EXCAVATED DROP INLET PROTECTION
 STA. VT 1+401.0, 10.9m LT.
 STA. VT 1+431.5, 29.0m LT.
 STA. VT 1+457.0, 13.7m LT.
 INLET PROTECTION DEVICE, TYPE (STONE & BLOCK)
 STA. VT 1+390.0, 6.5m LT.

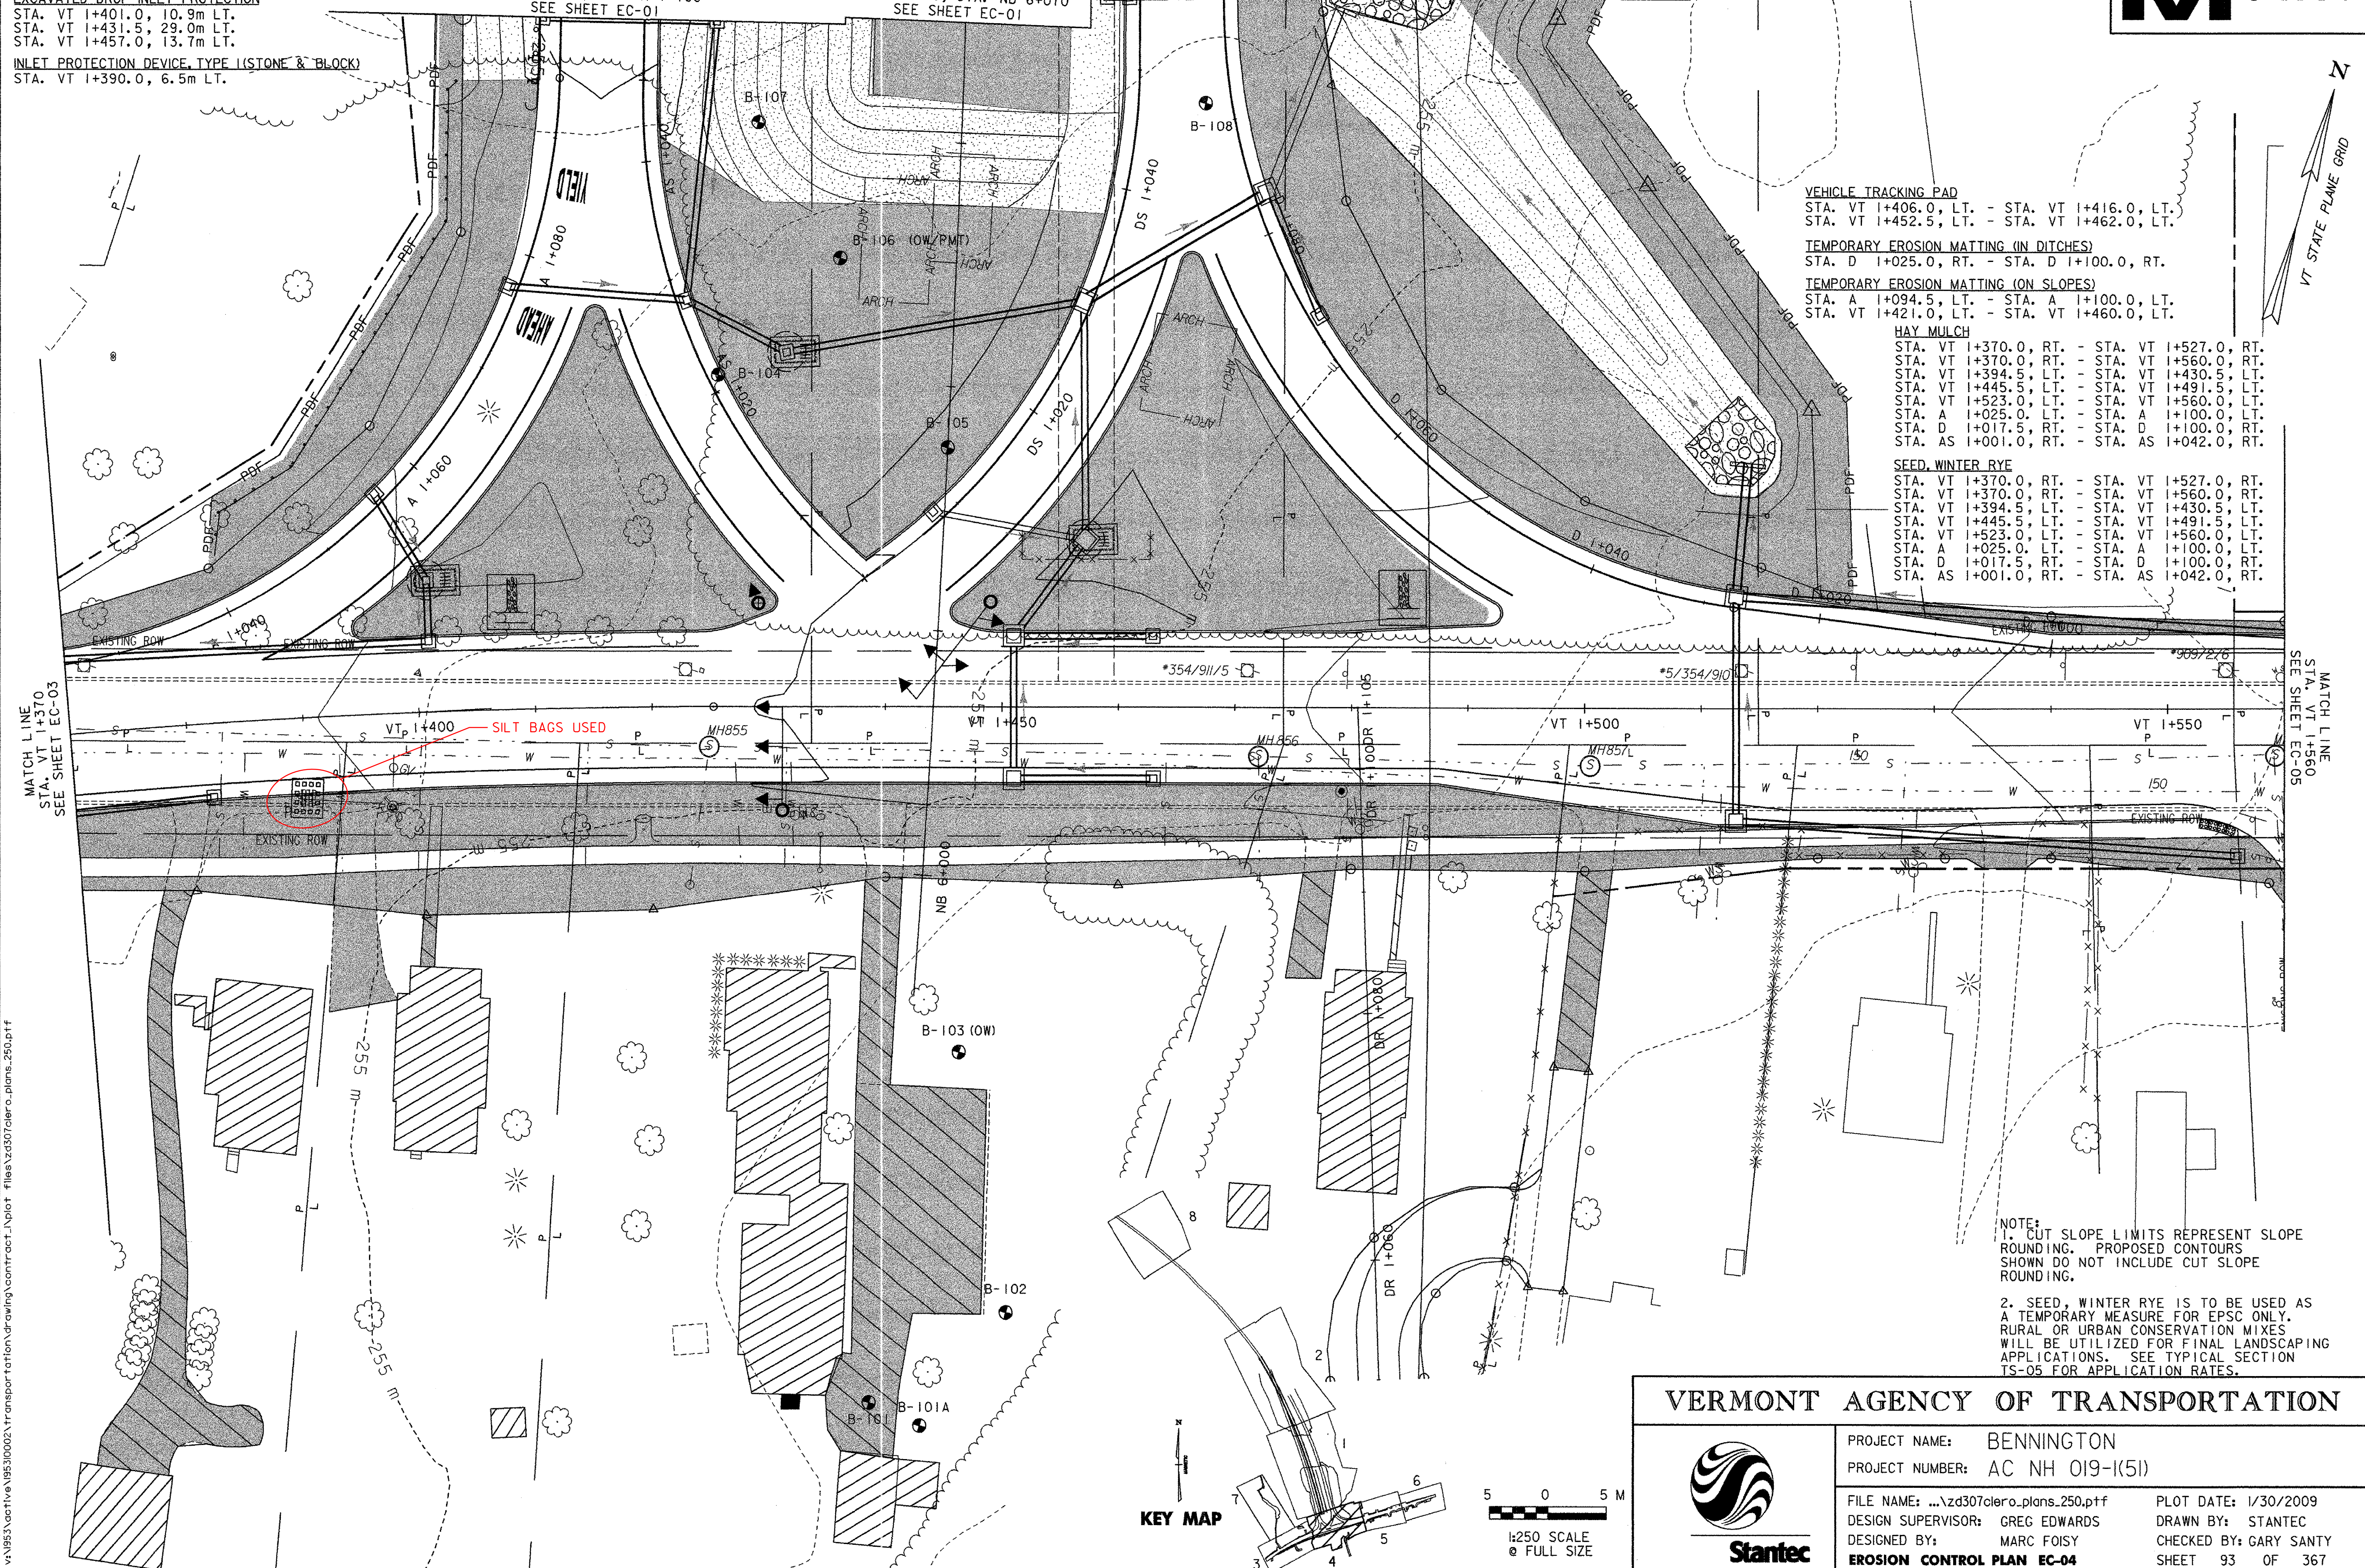

- VEHICLE TRACKING PAD**
 STA. VT 1+406.0, LT. - STA. VT 1+416.0, LT.
 STA. VT 1+452.5, LT. - STA. VT 1+462.0, LT.
- TEMPORARY EROSION MATTING (IN DITCHES)**
 STA. D 1+025.0, RT. - STA. D 1+100.0, RT.
- TEMPORARY EROSION MATTING (ON SLOPES)**
 STA. A 1+094.5, LT. - STA. A 1+100.0, LT.
 STA. VT 1+421.0, LT. - STA. VT 1+460.0, LT.
- HAY MULCH**
 STA. VT 1+370.0, RT. - STA. VT 1+527.0, RT.
 STA. VT 1+370.0, RT. - STA. VT 1+560.0, RT.
 STA. VT 1+394.5, LT. - STA. VT 1+430.5, LT.
 STA. VT 1+445.5, LT. - STA. VT 1+491.5, LT.
 STA. VT 1+523.0, LT. - STA. VT 1+560.0, LT.
 STA. A 1+025.0, LT. - STA. A 1+100.0, LT.
 STA. D 1+017.5, RT. - STA. D 1+100.0, RT.
 STA. AS 1+001.0, RT. - STA. AS 1+042.0, RT.
- SEED, WINTER RYE**
 STA. VT 1+370.0, RT. - STA. VT 1+527.0, RT.
 STA. VT 1+370.0, RT. - STA. VT 1+560.0, RT.
 STA. VT 1+394.5, LT. - STA. VT 1+430.5, LT.
 STA. VT 1+445.5, LT. - STA. VT 1+491.5, LT.
 STA. VT 1+523.0, LT. - STA. VT 1+560.0, LT.
 STA. A 1+025.0, LT. - STA. A 1+100.0, LT.
 STA. D 1+017.5, RT. - STA. D 1+100.0, RT.
 STA. AS 1+001.0, RT. - STA. AS 1+042.0, RT.

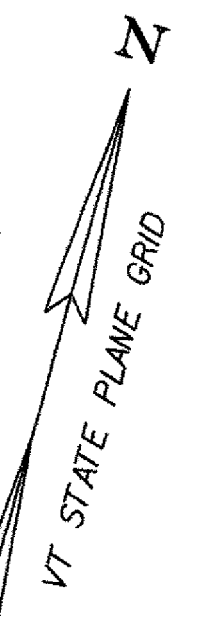

MATCH LINE
 STA. VT 1+370
 SEE SHEET EC-03

MATCH LINE
 STA. VT 1+560
 SEE SHEET EC-05



NOTE:
 1. CUT SLOPE LIMITS REPRESENT SLOPE ROUNDING. PROPOSED CONTOURS SHOWN DO NOT INCLUDE CUT SLOPE ROUNDING.
 2. SEED, WINTER RYE IS TO BE USED AS A TEMPORARY MEASURE FOR EPSC ONLY. RURAL OR URBAN CONSERVATION MIXES WILL BE UTILIZED FOR FINAL LANDSCAPING APPLICATIONS. SEE TYPICAL SECTION TS-05 FOR APPLICATION RATES.

VERMONT AGENCY OF TRANSPORTATION



PROJECT NAME: BENNINGTON
 PROJECT NUMBER: AC NH 019-1(51)
 FILE NAME: ...zd307clero_plans_250.ptf PLOT DATE: 1/30/2009
 DESIGN SUPERVISOR: GREG EDWARDS DRAWN BY: STANTEC
 DESIGNED BY: MARC FOISY CHECKED BY: GARY SANTY
EROSION CONTROL PLAN EC-04 SHEET 93 OF 367

KEY MAP

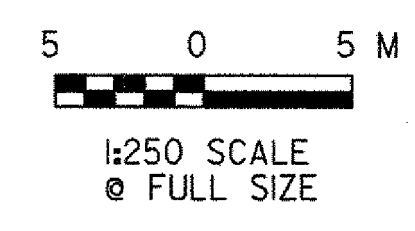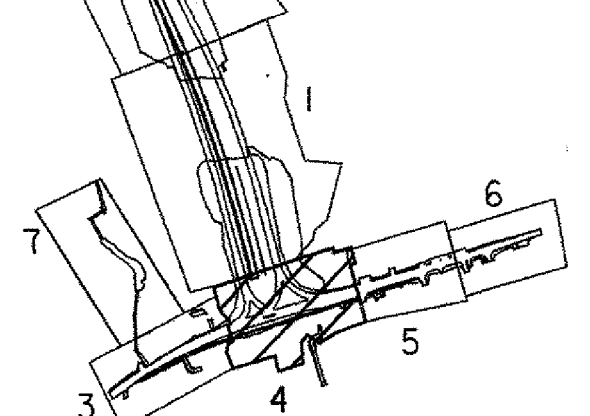

V:\953\sect1\va19530002A\transportation\drawing\contract\1\plot_files\zd307clero_plans_250.ptf