STATE OF VERMONT
AGENCY OF TRANSPORTATION

TRAFFIC SIGN SUMMARY SHEET

NOT Metric

KILOMETER MARKER, STATION, OR SIGN NUMBER	SIGN LEGEND	SIGN DIMENSIONS EA	WIDTH (mm)	HEIGHT (mm)	NEW & SALVAGED SIGNS "A"	"B"	SALV SIGN	SALV TIS	EXIST POST RETAIN	EXIST POST SALVAGE	NEW SIGN POSTS NO. OF POSTS	FLANGED CHANNEL kg/m 1.7	3.0	4.5	SQUARE STEEL (mm) 44 kg/m 2.8	50 kg/m 3.2	63 kg/m 5.0	ANCHOR	SLEEVE	TUBULAR ALUMINUM dia. (mm) 75 kg/m 1.9	100.0 kg/m 2.5	100 MOD. kg/m 2.5	FOUNDATION	TUBULAR STEEL dia. (mm) 75 kg/m 11.3	89 kg/m 13.4	100 kg/m 16.1	125 kg/m 21.7	W-SHAPE STEEL FTG. SIZE 600 mm	750 mm	WEIGHT	POST SIZE	SIGN FRAME REQUIRED	REMARKS	SIGN DETAIL DETAIL ON SHEET NUMBER	STD. SHEET NUMBER
											OPTION ITEMS																										
VT 279 STA. NB 6+570.0, LT.	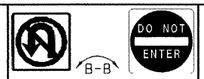	1 1	900 900	900 900	0.81 0.81						1						4.8	1																	R3-4 R5-1		SHS SHS
STA. NB 6+570.0, RT.	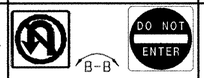	1 1	900 900	900 900	0.81 0.81						1						4.8	1																	R3-4 R5-1		SHS SHS
STA. NB 6+574.0, LT.		1	900	1200	1.08						2					10.3		2																	INSTALL (2) FLASHING BEACONS AS DETAILED ON VTRANS STANDARDS E-109 & E-175	TSD-01	
STA. NB 6+575.0, LT.		1	450	450	0.20						1				3			1																	OM1-1		SHS
STA. NB 6+657.5, RT.		1	900	1200	1.08						1						5.1	1																	R4-3		SHS
STA. NB 6+750.0, RT.		1	750	450	0.34						1				~~4.3~~ 3.8			1																		TSD-01	
STA. NB 6+775.0, LT.		1	3196	1590		5.08					2												2	89.6												TSD-02	
STA. NB 6+785.0, RT.		1 1	750 150	600 250	0.45 0.04						1				~~4.7~~ 4.3			1																	R8-7		SHS E-138
STA. NB 6+845.0, LT.		1	900	900.	0.81						2				~~9.7~~ 9.5			2																	W6-1		SHS
STA. NB 6+905.0, RT.		1 1	750 1125	375 900	0.28 1.01						2					9.4		2																			E-136B E-136B
STA. NB 7+037.0, RT.		1 1	1200 600	1200 450	1.44 0.27						2						10.6	2																		TSD-03	E-153B
STA. NB 7+050.0, LT.		1	900	900	0.81						2				9.7			2																	W7-1b (5%)		SHS
												m 0	m 0	m 0	m 31.4	m 19.7	m 25.3	EA 16	EA 0	kg 0	kg 0	kg 0		kg 89.6	kg 0	kg 0	kg 0								
TOTALS			m² 11.05	m² 5.08	EA 0.00	m² 0.00						m 0.0			m 76.4					kg			EA 2	kg 89.6				EA	EA	kg					

FINAL POST LENGTHS ARE TO BE DETERMINED IN THE FIELD. POST SIZES ARE COMPUTED BASED ON INFORMATION FURNISHED ON THE STANDARD SHEETS AND THE TRAFFIC & SAFETY DIVISION'S "SIGN POST DESIGN GUIDELINE."

MANUAL ON UNIFORM TRAFFIC CONTROL DEVICES (MUTCD), STANDARD HIGHWAY SIGNS (SHS)

Stantec

PROJECT NAME:	BENNINGTON		
PROJECT NUMBER:	AC NH 019-1(51)		
FILE NAME:	TRAFFIC SIGN SUMMARY.xls	PLOT DATE:	2/3/2009
PROJECT LEADER:	GREG EDWARDS	DRAWN BY:	STANTEC
DESIGNED BY:	MARC FOISY	CHECKED BY:	GARY SANTY
TRAFFIC SIGN SUMMARY SHEET TSS-01		SHEET	126 OF 367