STATE OF VERMONT
AGENCY OF TRANSPORTATION

TRAFFIC SIGN SUMMARY SHEET

Metric

KILOMETER MARKER, STATION, OR SIGN NUMBER	SIGN LEGEND	SIGN DIMENSIONS			NEW & SALVAGED SIGNS				EXIST POST		NEW SIGN POSTS																					REMARKS	SIGN DETAIL	
		EA	WIDTH (mm)	HEIGHT (mm)	"A"	"B"	SALV SIGN	SALV TIS	RETAIN	SALVAGE	NO. OF POSTS	FLANGED CHANNEL kg/m			SQUARE STEEL (mm) 44 kg/m	50 kg/m	63 kg/m	ANCHOR	SLEEVE	TUBULAR ALUMINUM dia. (mm) 75 kg/m	100.0 kg/m	100 MOD. kg/m	FOUNDATION	TUBULAR STEEL dia. (mm) 75 kg/m	89 kg/m	100 kg/m	125 kg/m	W-SHAPE STEEL FTG. SIZE 600 mm	750 mm	WEIGHT	POST SIZE	SIGN FRAME REQUIRED		DETAIL ON SHEET NUMBER	STD. SHEET NUMBER
												1.7	3.0	4.5	2.8	3.2	5.0			1.9	2.5	2.5		11.3	13.4	16.1	21.7								
											OPTION ITEMS																									
RAMP AS																																			
STA. AS 1+008.0, LT.		1 1 1	900 900 900	900 300. 300	0.81 0.27 0.27						1					4.1		1																	R5-1 INSTALL "ONE WAY" SIGNS USING BRACKET ON VTRANS STANDARD E-160, MOUNTED AS SHOWN ON VTRANS STANDARD E-120. R6-1L R6-1R		SHS SHS SHS
STA. AS 1+008.0, RT.		1 1 1	900 900 900	900 300. 300	0.81 0.27 0.27						1					4.1		1																	R5-1 INSTALL "ONE WAY" SIGNS USING BRACKET ON VTRANS STANDARD E-160, MOUNTED AS SHOWN ON VTRANS STANDARD E-120. R6-1L R6-1R		SHS SHS SHS
RAMP D																																			
STA. D 1+050.0, RT.		1	900	900	0.81						1					~~3.9~~ 3.73		1																			E-142
STA. D 1+070.0, RT.		1	900	900	0.81						2				~~7.8~~ 7.67			2																			W4-1L		SHS
STA. D 1+220.0, RT.		1 1	1140 150	780 200	0.89 0.03						2				9			2																			TSD-03 E-134
STA. D 1+520.0, RT.	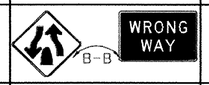	1 1	900 900	900 600	0.81 0.54						2				8.6			2																			W6-2 MOUNT SIGNS BACK-TO-BACK R5-1a		SHS SHS
STA. D 1+520.0, LT.		1	900	600	0.54						1				3.6			1																			R5-1a		SHS
RAMP DS																																			
STA. DS 1+017.5, RT.		1	900	900	0.81						2				~~7.8~~ 8.2			2																				TSD-03	
STA. DS 1+030.0, RT.		1	900	900	0.81						1					~~3.9~~ 3.5		1																			E-142
												m 0	m 0	m 0	m 36.8	m 16	m 0	EA 13	EA 0	kg 0	kg 0	kg 0		kg 0	kg 0	kg 0	kg 0								
TOTALS					m^2 8.75	m^2 0.00	EA 0.00	m^2 0.00				m 0.0			m 52.8					kg			EA	kg				EA	EA	kg					

FINAL POST LENGTHS ARE TO BE DETERMINED IN THE FIELD. POST SIZES ARE COMPUTED BASED ON INFORMATION FURNISHED ON THE STANDARD SHEETS AND THE TRAFFIC & SAFETY DIVISION'S "SIGN POST DESIGN GUIDELINE."

MANUAL ON UNIFORM TRAFFIC CONTROL DEVICES (MUTCD), STANDARD HIGHWAY SIGNS (SHS)

Stantec

PROJECT NAME:	**BENNINGTON**		
PROJECT NUMBER:	**AC NH 019-1(51)**		
FILE NAME:	**TRAFFIC SIGN SUMMARY.xls**	PLOT DATE:	**2/3/2009**
PROJECT LEADER:	**GREG EDWARDS**	DRAWN BY:	**STANTEC**
DESIGNED BY:	**MARC FOISY**	CHECKED BY:	**GARY SANTY**
TRAFFIC SIGN SUMMARY SHEET TSS-07		SHEET	**132** OF **367**