Metric

DS 1+055.735 = D 1+099.813, 7.2m LT.

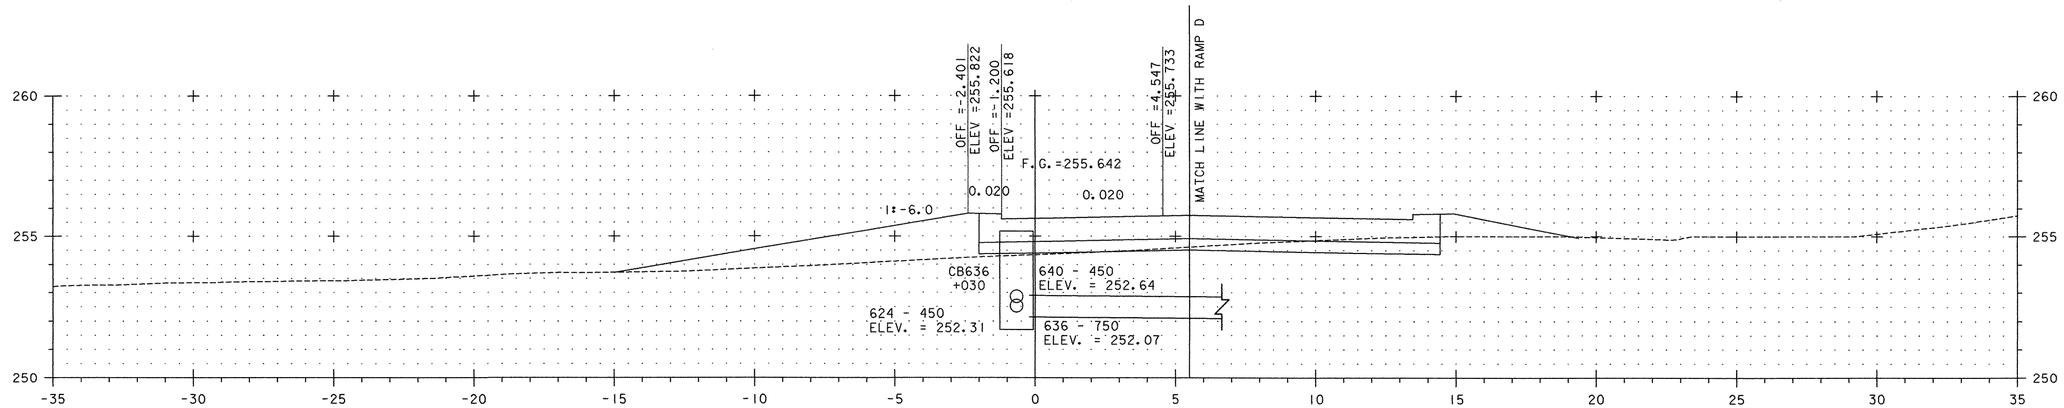

DS 1+040

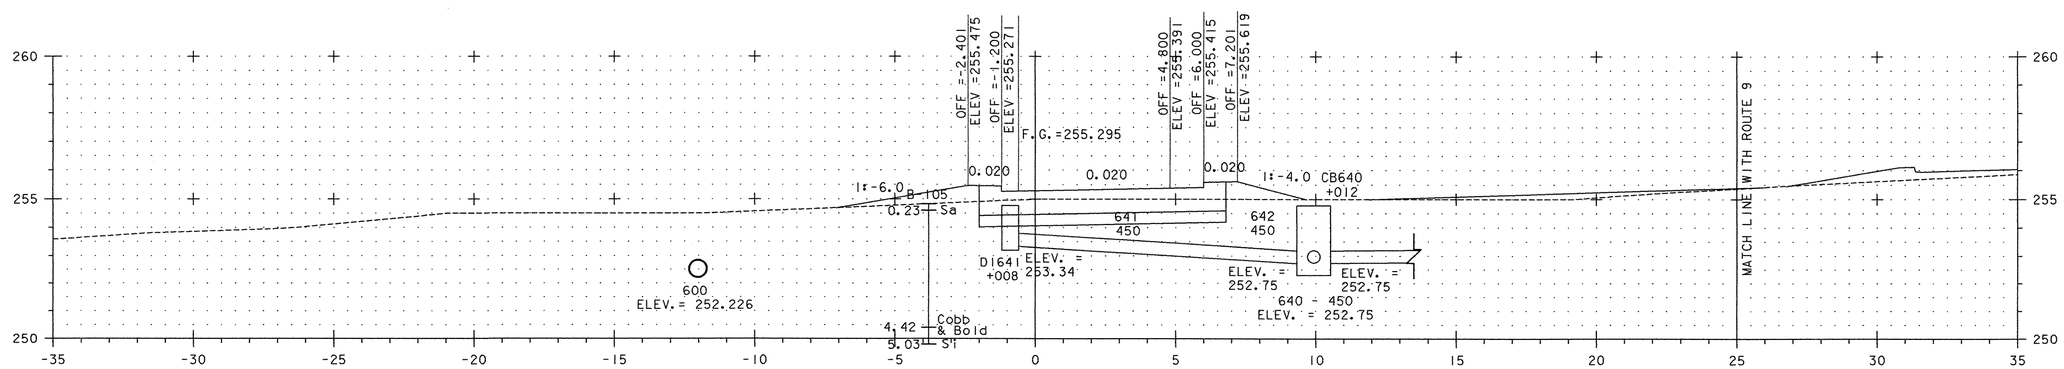

DS 1+020

DS 1+000.000 = VT 1+438.235, 10.579m LT.

5 METERS
2.5
H 1:100 SCALE
V 1:100 SCALE
@ FULL SIZE
2.5
5 METERS

VERMONT AGENCY OF TRANSPORTATION

Stantec

PROJECT NAME: BENNINGTON
PROJECT NUMBER: AC NH 019-1(51)

FILE NAME: ...\plot files\zd307clxs_ds.ptf
DESIGN SUPERVISOR: GREG EDWARDS
DESIGNED BY: MARC FOISY
SLIP RAMP D CROSS SECTIONS DSX-01

PLOT DATE: 1/29/2009
DRAWN BY: STANTEC
CHECKED BY: GARY SANTY
SHEET 336 OF 367

H:\1953\active\195310002\transportation\drawing\contract_1\plot files\zd307clxs_ds.ptf