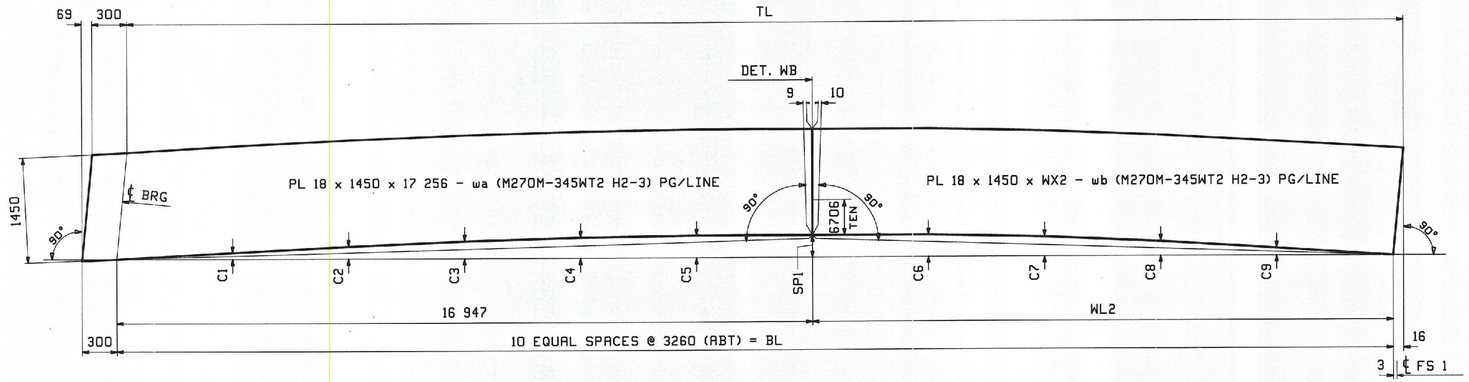

CAMBER DIAGRAM FOR 201G1A, 202G2A, 203G3A, 204G4A

MARK	TL	BL	WL2	WX2	SP1	C1	C2	C3	C4	C5	C6	C7	C8	C9	PG/LINE wa	PG/LINE wb
201G1A	32 543	32 596	15 649	15 664	101	30	57	79	93	101	100	88	66	34	203/ A	202/ S
202G2A	32 540	32 593	15 646	15 662	105	32	60	82	96	104	104	92	68	35	202/ W	202/ N
203G3A	32 538	32 591	15 644	15 659	104	31	59	81	96	104	103	91	68	35	202/ W	202/ N
204G4A	32 534	32 587	15 640	15 656	104	30	58	81	96	104	102	91	68	36	203/ A	202/ N

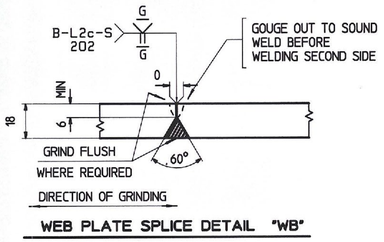

WEB PLATE SPLICE DETAIL "WB"

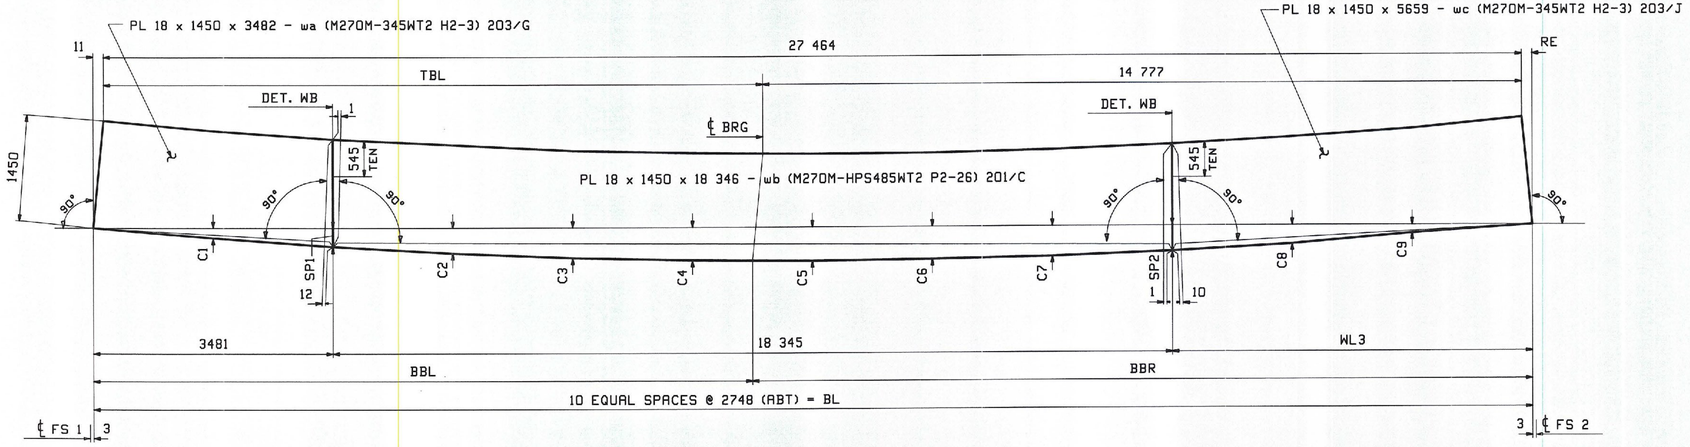

CAMBER DIAGRAM FOR 205G1B, 206G2B, 207G3B, 208G4B

MARK	BL	RE	WL3	SP1	SP2	TBL	BBL	BBR	C1	C2	C3	C4	C5	C6	C7	C8	C9
205G1B	27 484	9	5658	29	37	12 687	12 616	14 868	22	42	58	71	73	65	52	36	18
206G2B	27 485	10	5659	28	39	12 687	12 616	14 869	22	43	61	74	76	68	54	37	19
207G3B	27 485	10	5659	27	39	12 687	12 616	14 869	22	41	59	72	75	67	54	37	19
208G4B	27 483	9	5657	27	38	12 686	12 615	14 868	21	42	59	71	74	66	53	36	18

NOTES:
1. All MATL M270M, GR345W UNLESS OTHERWISE NOTED
2. FOR GENERAL NOTES WB SEE SHT GN1
3. H2-3 DENOTES MATERIAL SUBJECT TO CHARPY V NOTCH TESTING ZONE 2 , H FREQ , 20 J @ 4 deg C (15 Ft/lbs @ 40 deg F)
4. P2-26 DENOTES MATERIAL SUBJECT TO CHARPY V NOTCH TESTING ZONE 2, P FREQ., 34 J @ -23 deg C (25 Ft/lbs @ -10 deg F)

TVGA CONSULTANTS
☒ NO EXCEPTIONS TAKEN ☐ REJECTED
☐ FURNISH AS CORRECTED
☐ REVISE AND RESUBMIT
ENGINEER has reviewed Shop Drawings and Samples and other data which Contractor is required to submit, only for conformance with the information given in the Contract Documents and compatibility with the design concept of the completed Project as a functioning whole as indicated in the Contract Documents. Such review does not extend to means, methods, techniques, sequences or procedures of construction or to safety precautions and programs incident thereto. Such review does not extend to any LEED certification or accreditation. Contractor is responsible for dimensions to be confirmed and correlated at the job site, for information that pertains solely to the fabrication processes or to techniques of construction and for coordination of the work of all trades.
BY: JJM
DATE: 11-05-09

REV.	DATE	REMARKS	DWN	CHK	APVL	SHOP
0					SEP 04 2009	

MATERIAL:	SURFACE PREP. & PAINT:	HOLES:	SHOP BOLTS:
		AS NOTED	AS NOTED

DESCRIPTION: CAMBER DIAGRAM

CASCO BAY STEEL STRUCTURES, INC.
75 SPRING HILL ROAD SACO, MAINE 04072
PHONE (207) 282-7360 FAX. (207) 282-1179

TENSOR 2886-2

STRUCTURE: RAMP D VT RTE 279 OVER WALLOOMSAC RIVER BRIDGE NO. B15N BENNINGTON COUNTY	DRAWN: KC	DATE: 06/30
	CHKD: WJL	DATE: 07/09
LOCATION: BENNINGTON, VERMONT	JOB NO.	DWG NO.
PROJ NO. AC NH 019-1(51)	408-2	C201
CUSTOMER: KUBRICKY CONSTRUCTION		REV. △

ES Mon, Aug 24, 2009 10:41:47 P:\...\casco_bay\2886-2\C201.dwg