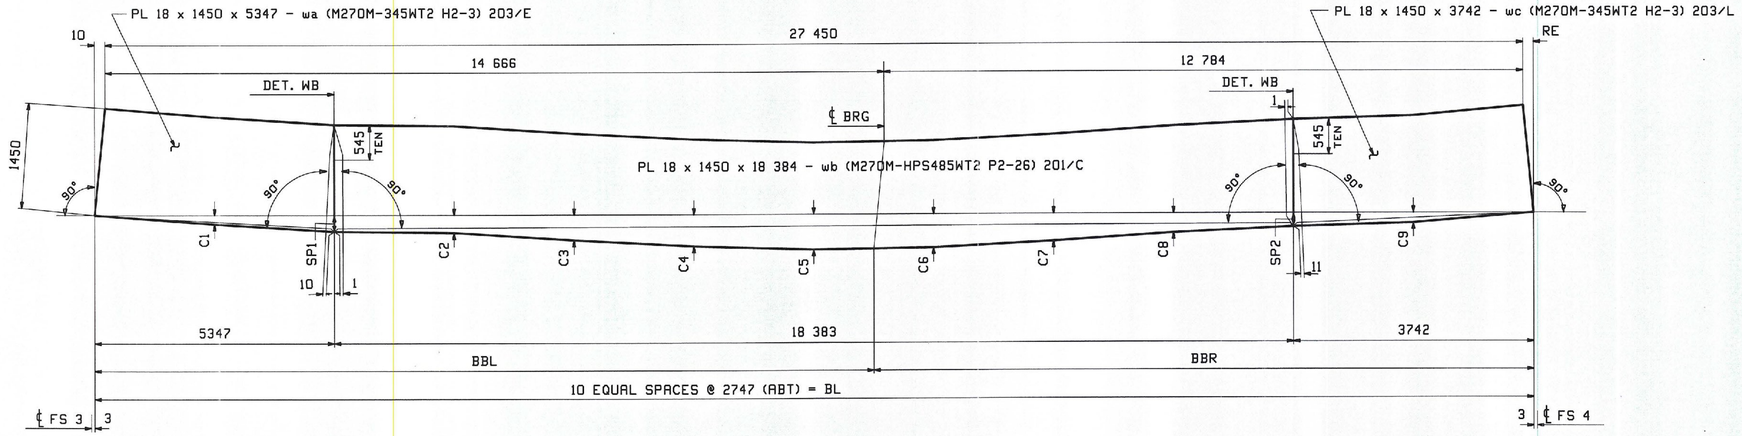

CAMBER DIAGRAM FOR 213G1D, 214G2D, 215G3D, 216G4D

MARK	BL	RE	SP1	SP2	BBL	BBR	C1	C2	C3	C4	C5	C6	C7	C8	C9
213G1D	27 471	11	36	28	14 597	12 874	19	37	53	66	73	70	57	41	21
214G2D	27 472	12	38	30	14 596	12 876	20	39	56	69	77	73	59	42	22
215G3D	27 472	12	37	30	14 596	12 876	19	38	54	67	76	72	59	42	22
216G4D	27 472	12	36	30	14 596	12 876	19	37	53	67	75	71	58	42	22

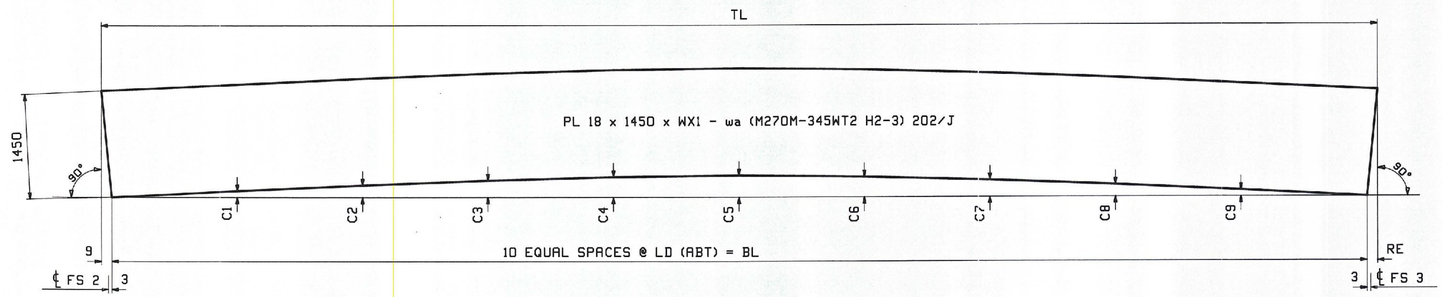

CAMBER DIAGRAM FOR 209G1C, 210G2C, 211G3C, 212G4C

MARK	TL	BL	RE	WX1	LD	C1	C2	C3	C4	C5	C6	C7	C8	C9
209G1C	24 902	24 884	9	24 902	2490	15	28	39	47	50	47	39	28	15
210G2C	24 897	24 879	9	24 897	2490	15	29	41	50	54	50	41	29	15
211G3C	24 892	24 874	9	24 892	2485	15	29	40	48	52	48	40	28	15
212G4C	24 888	24 871	8	24 888	2485	14	27	38	46	50	46	38	27	14

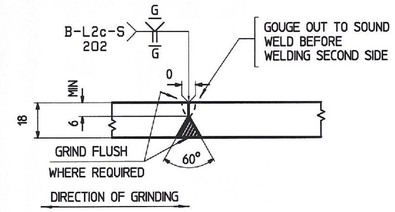

WEB PLATE SPLICE DETAIL "WB"

NOTES:
1. All MATL M270M, GR345W UNLESS OTHERWISE NOTED
2. FOR GENERAL NOTES SEE SHT GN1
3. H2-3 DENOTES MATERIAL SUBJECT TO CHARPY V NOTCH TESTING
   ZONE 2 , H FREQ , 20 J @ 4 deg C (15 Ft/lbs @ 40 deg F)
4. P2-26 DENOTES MATERIAL SUBJECT TO CHARPY V NOTCH TESTING
   ZONE 2, P FREQ., 34 J @ -23 deg C (25 Ft/lbs @ -10 deg F)

TVGA CONSULTANTS

☒ NO EXCEPTIONS TAKEN ☐ REJECTED
☐ FURNISH AS CORRECTED
☐ REVISE AND RESUBMIT
ENGINEER has reviewed Shop Drawings and Samples and other data which Contractor is required to submit, only for conformance with the information given in the Contract Documents and compatibility with the design concept of the completed Project as a functioning whole as indicated in the Contract Documents. Such review does not extend to means, methods, techniques, sequences or procedures of construction or to safety precautions and programs incident thereto. Such review shall not extend to any LEED certification or accreditation. Contractor is responsible for dimensions to be confirmed and correlated at the jobsite, for information that pertains solely to the fabrication processes or to techniques of construction, and for coordination of the work of all trades.

BY: JJW
DATE: 11-05-09

REV.	DATE	REMARKS	DWN	CHK	APVL	SHOP
D	SEP 04 2009					

MATERIAL:	SURFACE PREP. & PAINT:	HOLES:	SHOP BOLTS:
		AS NOTED	AS NOTED

DESCRIPTION: CAMBER DIAGRAM

CASCO BAY STEEL STRUCTURES, INC.
75 SPRING HILL ROAD SACO, MAINE 04072
PHONE (207) 282-7360 FAX. (207) 282-1179

TENSOR 2686-2

STRUCTURE: RAMP D VT RTE 279 OVER WALLOOMSAC RIVER BRIDGE NO. B15N BENNINGTON COUNTY		DRAWN: KC	DATE: 06/30
		CHKD: WJL	DATE: 07/09
LOCATION: BENNINGTON, VERMONT		JOB NO. 408-2	DWG NO. C202
PROJ NO. AC NH 019-1(51)			REV. △
CUSTOMER: KUBRICKY CONSTRUCTION			

Mon, Aug 24, 2009 12:25:26 PM //users/jobs/2686-2/202 - Rev0