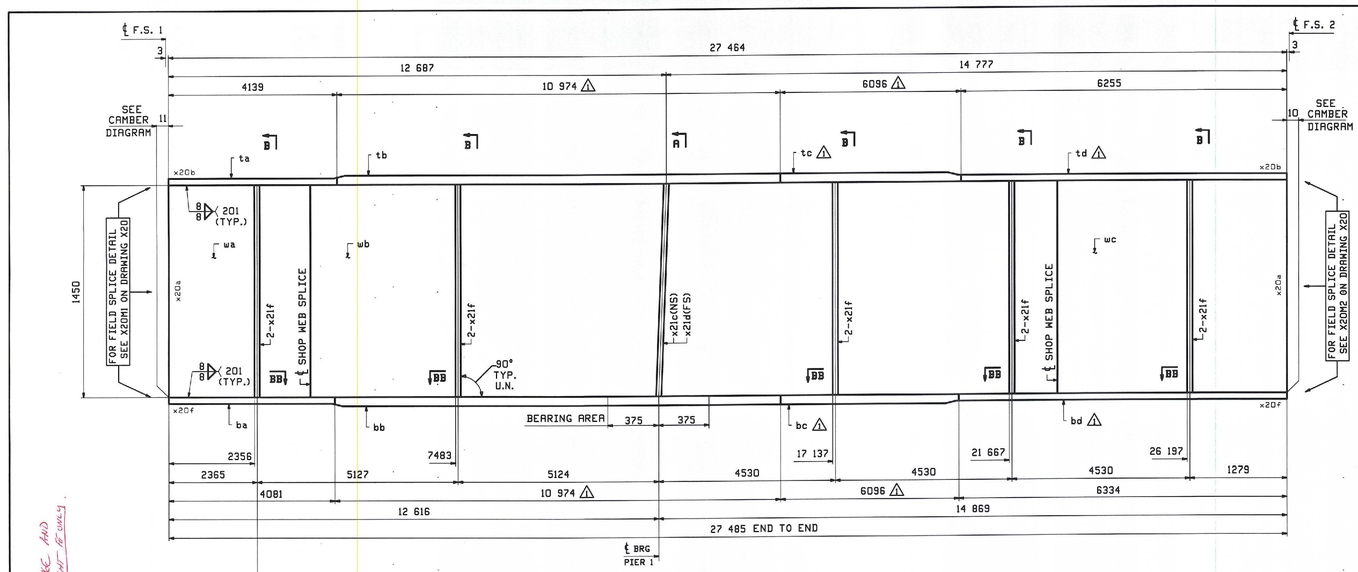

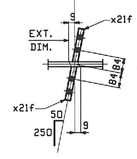

SECTION BB

NO WELD BETWEEN TOP FLANGE AND STIFFENERS AT THE PLATE MUST BE CONT.

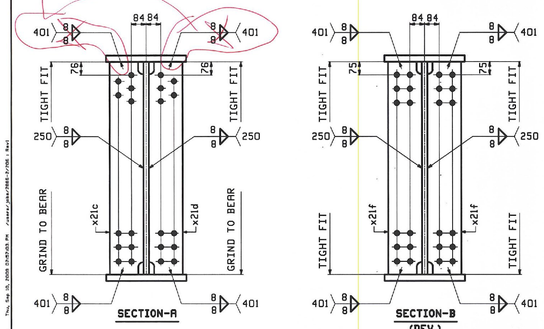

SECTION-A

SECTION-B (DEV.)

ONE - GIRDER - 206G2B (DEV.)

FOR FIELD SPLICE DETAILS SEE SHT.X20.
FOR GIRDER STANDARDS SEE SHT.X21.
FOR CAMBER DIAGRAM SEE SHT.C201.
FOR FLANGE DIAGRAM SEE SHT.F202.
FOR GENERAL NOTES SEE SHT.GN1.

ABN INFO		SHIP	BILL OF MATERIAL					JOB NO.	DRAWING NO.	REV.
								408-2	206	⚠
PAGE	LINE	MARK	QTY	MARK	MATERIAL	LENGTH m	LENGTH mm	REMARKS	WT	PROCUREMENT NOTES
		206G2B	1		GIRDER				16174 kg 35647 lbs	
203	G		1	wa	PL 18×1450	3	482	×270M-345WT2 (42-3)		
201	C		1	wb	PL 18×1450	18	346	×270M-HPS485WT2 (P2-26)		
203	J		1	wc	PL 18×1450	5	659	×270M-345WT2 (42-3)		
201	Y		1	ta	PL 42×460	4	139	×270M-345WT2 (42-3)		
⚠ 201	A		1	tb	PL 56×460	10	574	×270M-HPS485WT2 (P2-26)		
⚠ 201	B		1	tc	PL 56×460	6	096	×270M-HPS485WT2 (P2-26)		
⚠ 201	Q		1	td	PL 42×460	8	255	×270M-345WT2 (42-3)		
201	Y		1	ba	PL 42×460	4	081	×270M-345WT2 (42-3)		
⚠ 201	A		1	bb	PL 56×460	10	974	×270M-HPS485WT2 (P2-26)		
⚠ 201	B		1	bc	PL 56×460	6	096	×270M-HPS485WT2 (P2-26)		
⚠ 201	N		1	bd	PL 42×460	8	334	×270M-345WT2 (42-3)		
204	B		1	x21c	PL 25×200	1	452	×270M-345WT2 (42-3)		
204	B		1	x21d	PL 25×200	1	452	×270M-345WT2 (42-3)		
204	C		10	x21f	PL 14×200	1	450	×270M-345WT2 (42-3)		

68

PLAN VIEW

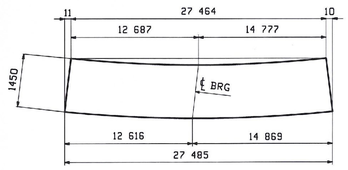

DEV. ORIENTATION DIAGRAM
FOR CAMBER SEE DWG C201

TVGA CONSULTANTS
☐ NO EXCEPTIONS TAKEN ☐ REJECTED
☐ FURNISH AS CORRECTED
☐ REVISE AND RESUBMIT
ENGINEER has reviewed Shop Drawings and Samples and other data which Contractor is required to submit, only for conformance with the information given in the Contract Documents and compatibility with the design concept of the completed Project as a functioning whole as indicated in the Contract Documents. Such review shall not extend to means, methods, techniques, sequencing or procedures of construction or to safety precautions and programs incident thereto. Such review shall not extend to any deviation from or acceptable. Contractor is responsible for dimensions to be confirmed and correlated at the job site, for information that pertains solely to the fabrication processes or to techniques of construction, and for coordination of the work of all trades.
BY: [illegible]
DATE: 11-22-09

REV.	DATE	REMARKS	DWN	CHK	APVL	SHOP
⚠	09/08	ADDED FLG SPLICE TO 56mm FLGS	EEO	DO	9-22-09	

MATERIAL:	SURFACE PREP. & PAINT:	HOLES:	SHOP BOLTS:
AS NOTED	SEE DWG GN1	15/16"ø	NONE

DESCRIPTION: GIRDER - 206G2B

CASCO BAY STEEL STRUCTURES, INC.
75 SPRING HILL ROAD SACO, MAINE 04072
PHONE (207) 282-7360 FAX. (207) 282-1179

TENSOR 2006-2

STRUCTURE:	RAMP D VT RTE 279 OVER WALLOOMSAC RIVER BRIDGE NO. B15N BENNINGTON COUNTY	DRAWN: WR	DATE: 07/13
		CHKD: DO	DATE: 08/17
LOCATION:	BENNINGTON, VERMONT	JOB NO.	DWG NO.
PROJ NO.	AC NH 019-1(51)	408-2	206
CUSTOMER:	KUBRICKY CONSTRUCTION		REV. ⚠