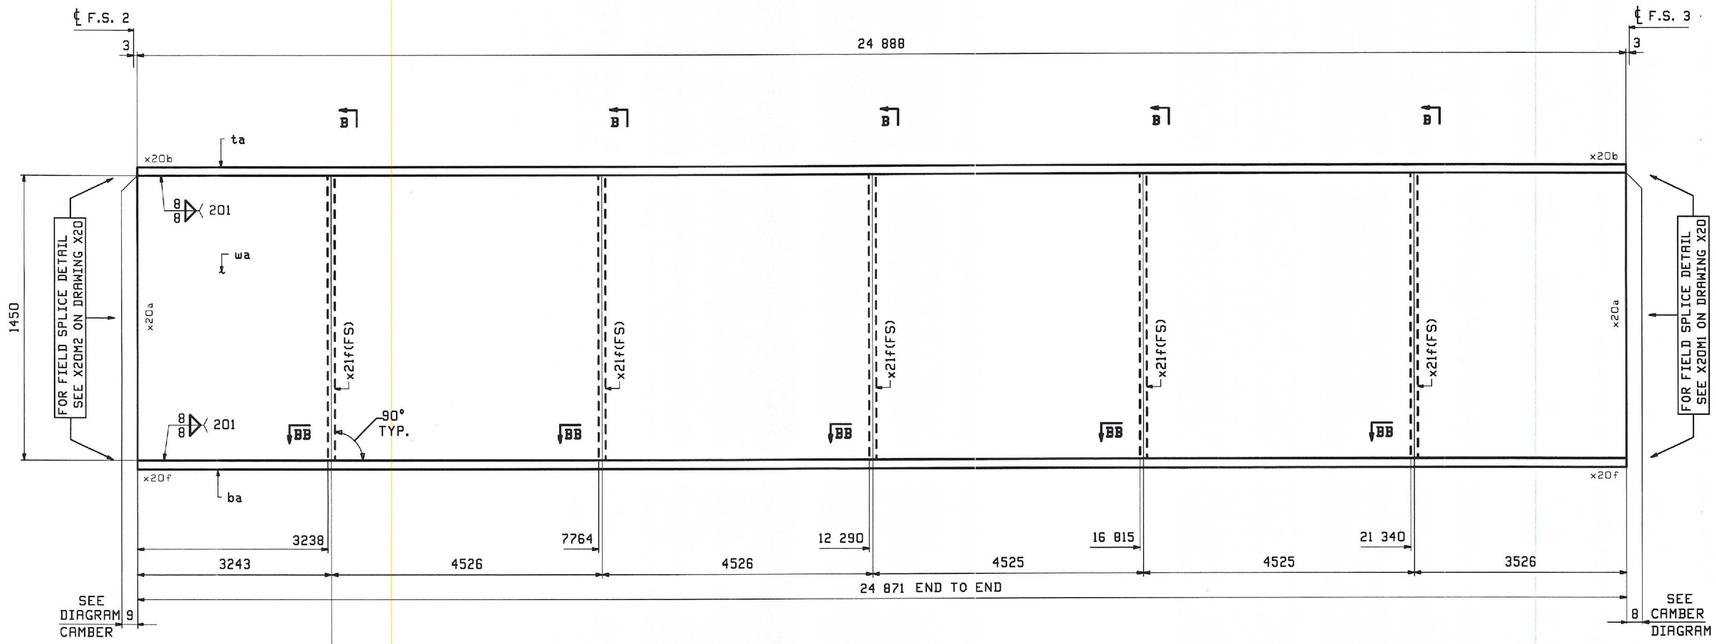

ONE - GIRDER - 212G4C (DEV.)

FOR FIELD SPLICE DETAILS SEE SHT.X20.
FOR GIRDER STANDARDS SEE SHT.X21.
FOR CAMBER DIAGRAM SEE SHT.C202.
FOR FLANGE DIAGRAM SEE SHT.F203.
FOR GENERAL NOTES SEE SHT.GN1.

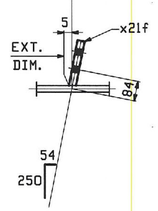

SECTION BB

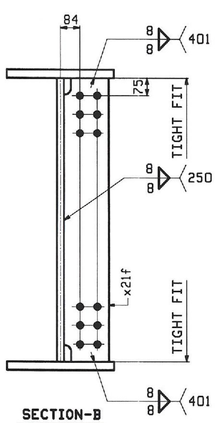

SECTION-B (DEV.)

ABM INFO		SHIP	BILL OF MATERIAL					JOB NO.	DRAWING NO.	REV.
								408-2	212	
PAGE	LINE	MARK	QTY	MARK	MATERIAL	LENGTH m	LENGTH mm	REMARKS	WT	PROCUREMENT NOTES
		212G4C	1		GIRDER				11277 kg 24881 lb	
202	J		1	wa	PL 18x1450	24	888	M270M-345WT2 (H2-3)		
202	A		1	ta	PL 25x450	24	888	M270M-345WT2 (H2-3)		
201	E		1	ba	PL 42x450	24	871	M270M-345WT2 (H2-3)		
204	C		5	x21f	PL 14x200	1	450	M270M-345WT2 (H2-3)		

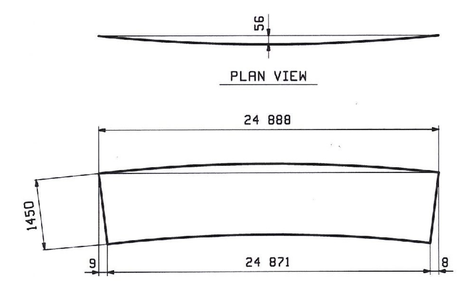

DEV. ORIENTATION DIAGRAM
FOR CAMBER SEE DWG C202

TVGA CONSULTANTS
☒ NO EXCEPTIONS TAKEN ☐ REJECTED
☐ FURNISH AS CORRECTED
☐ REVISE AND RESUBMIT
ENGINEER has reviewed Shop Drawings and Samples and other data which Contractor is required to submit, only for conformance with the information given in the Contract Documents and compatibility with the design concept of the completed Project as a functioning whole as indicated in the Contract Documents. Such reviews do not extend to means, methods, techniques, sequences or procedures of construction or to safety precautions and programs incident thereto. Such reviews do not extend to any CSD certification or accreditation. Contractor is responsible for dimensions to be confirmed and correlated at the job site, for information that pertains solely to the fabrication processes or to techniques of construction, and for coordination of the work of all trades.
BY: JM
DATE: 11-05-09

REV.	DATE	REMARKS	DWN	CHK	APVL	SHOP
0					SEP 04 2009	

MATERIAL:	SURFACE PREP. & PAINT:	HOLES:	SHOP BOLTS:
AS NOTED	SEE DWG GN1	15/16"Ø	NONE

DESCRIPTION: GIRDER - 212G4C

CASCO BAY STEEL STRUCTURES, INC.
75 SPRING HILL ROAD SACO, MAINE 04072
PHONE (207) 282-7360 FAX. (207) 282-1179
TENSOR 2886-2

STRUCTURE:	RAMP D VT RTE 279 OVER WALLOOMSAC RIVER BRIDGE NO. B15N BENNINGTON COUNTY	DRAWN: WR	DATE: 07/13
		CHKD: DO	DATE: 08/17
LOCATION:	BENNINGTON, VERMONT	JOB NO.	DWG NO.
PROJ NO.	AC NH 019-1(51)	408-2	212
CUSTOMER:	KUBRICKY CONSTRUCTION		REV. △

Mon, Aug 24, 2009 03:30:10 PM /users/jobs/2886-2/212.1 GenD