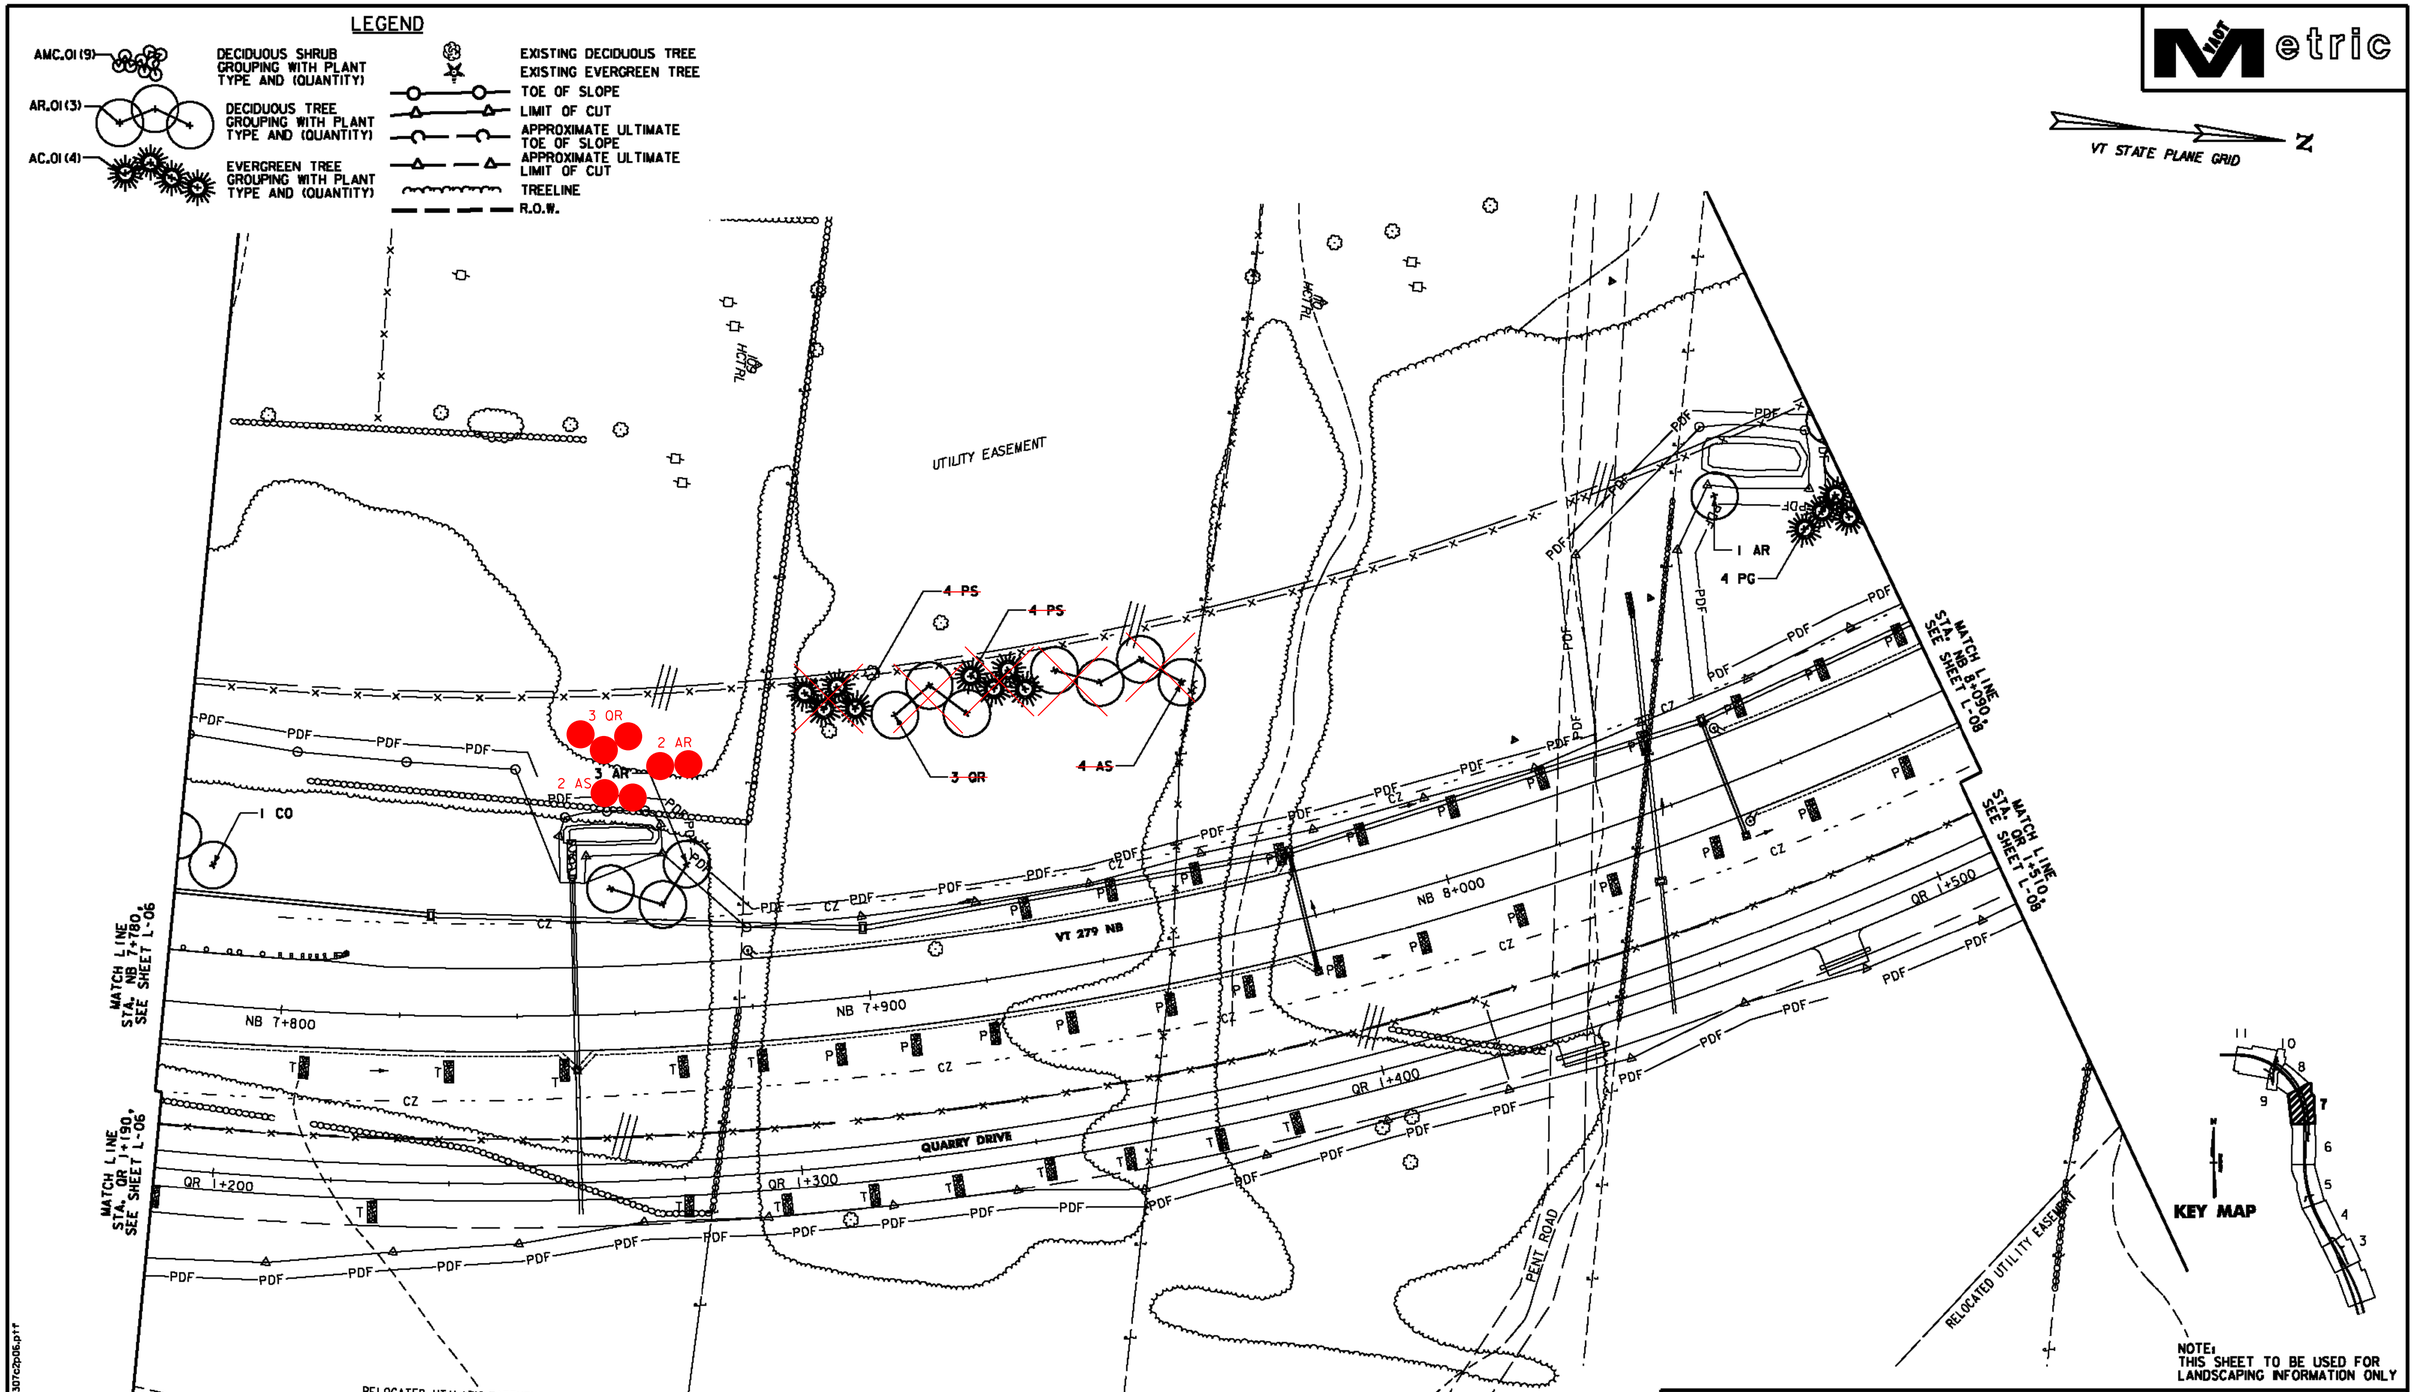

Metric

VERMONT AGENCY OF TRANSPORTATION

DuBois & King inc.

PROJECT NAME: BENNINGTON - NORTH
PROJECT NUMBER: BENNINGTON AC NH 019-1(52)

FILE NAME: ...\DGN\zd307c2p06.ptf
DESIGN SUPERVISOR: J. BENSON
DESIGNED BY: J. STEELE/C. BRODIE
LANDSCAPE PLAN L-07

PLOT DATE: 12/10/2007
DRAWN BY: E. SMALL
CHECKED BY: J. STEELE
SHEET 146 OF

I:\R3463PE\CONTRACT NO 2\DGN\zd307c2p06.ptf