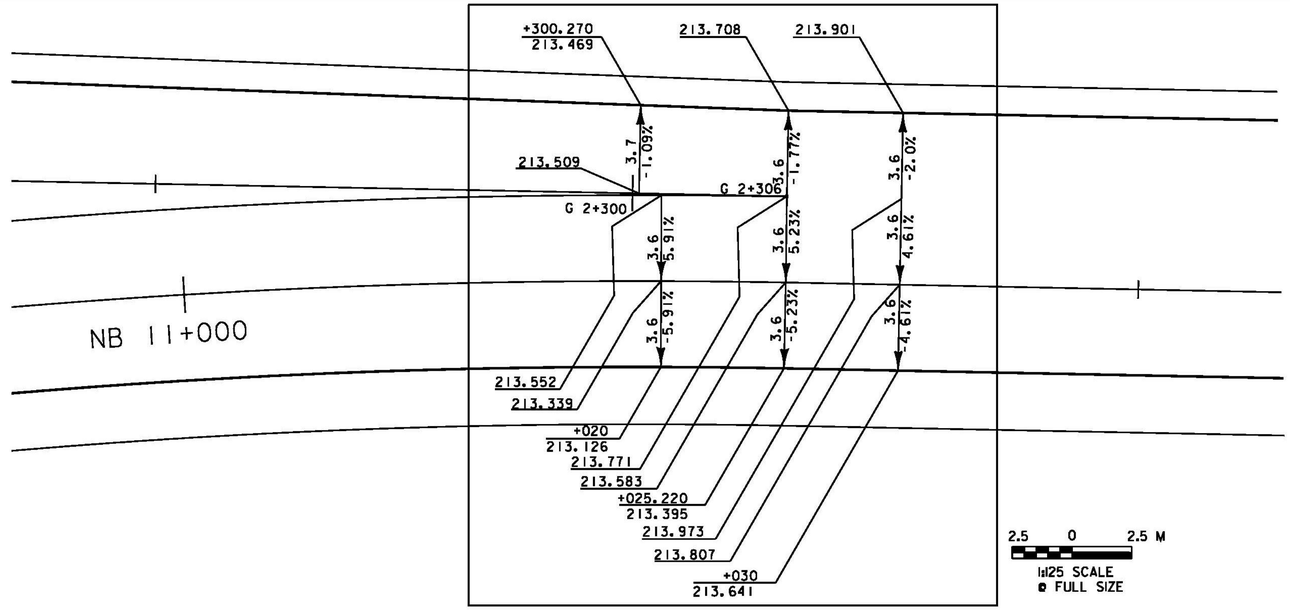

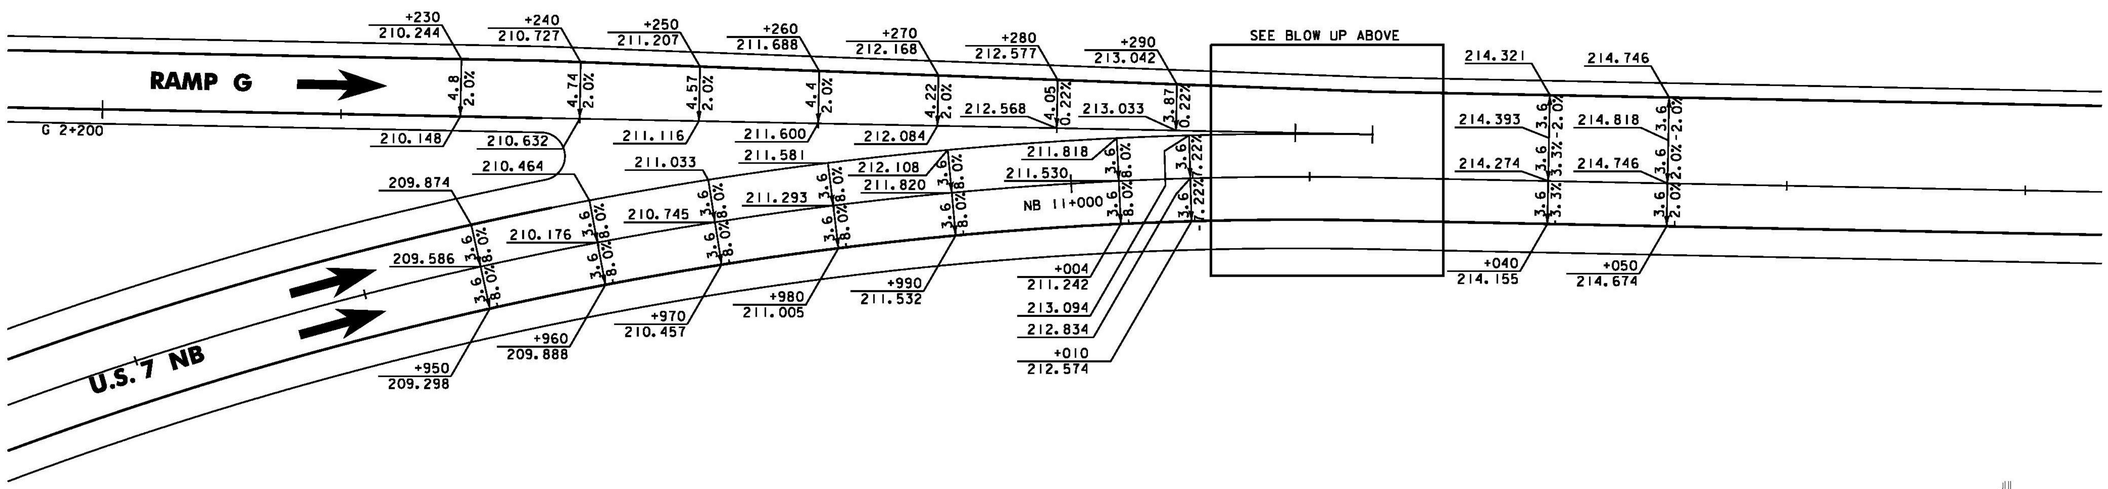

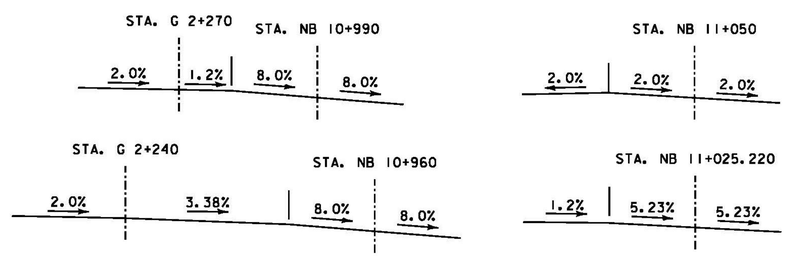

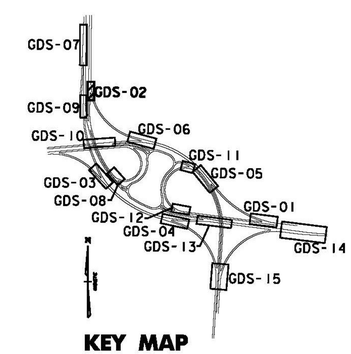

KEY MAP

U.S. ROUTE 7 NORTHBOUND / RAMP G MERGE

CRITICAL CROSS SECTIONS

N. T. S.

FOR ADDITIONAL INFORMATION
SEE CROSS SECTION SHEETS:
NBX-23, NBX-24, GXS-11, GSX-12

5 0 5 M
1:250 SCALE
@ FULL SIZE

Stantec

PROJECT NAME: BENNINGTON
PROJECT NUMBER: NH 019-1(54)

FILE NAME: ...\plot_files\zd307c4det_gore.ptf PLOT DATE: 1/26/2010
DESIGN SUPERVISOR: GREG EDWARDS DRAWN BY: STANTEC
DESIGNED BY: MARC FOISY CHECKED BY: GARY SANTY
GORE DETAIL SHEET – GDS-02 SHEET 31 OF 468

1/26/2010 4:46:17 PM v:\1953\active\195300002\transportation\drawing\contract_4\plot_files\zd307c4det_gore.ptf