


CURVE NB8	CURVE EI	CURVE NI	CURVE XOI
$\Delta = 7^{\circ}15'00.0''$ RT. R. = 2380.000m T. = 150.780m L. = 301.157m E. = 4.771m BANK = 0.021 PI STA. NB9+411.767 N = 44859.7018 E = 443427.1540 PC N = 44859.7018 E = 443577.9337 PT N = 44878.7300 E = 443277.5798	$\Delta = 47^{\circ}02'33.6''$ RT. R. = 340.000m T. = 147.987m L. = 276.157m E. = 30.810m BANK = 0.060 PI STA EI+152.477 N = 44931.1345 E = 442951.2506 PC N = 44912.4568 E = 443098.0539 PT N = 45051.3022 E = 442864.8804	$\Delta = 93^{\circ}41'00.4''$ RT. R. = 318.482m T. = 339.644m L. = 520.745m E. = 147.124m BANK = 0.060 PI STA. NI+339.644 N = 44878.5329 E = 442883.0050 PC N = 44539.5464 E = 442861.8761 PT N = 44835.6697 E = 443219.9338	$\Delta = 4^{\circ}12'34.4''$ RT. R. = 2500.000m T. = 91.880m L. = 183.677m E. = 1.688m BANK = 0.000 PI STA XO 1+487.027 N = 44859.7018 E = 443789.0399 PC N = 44852.9574 E = 443697.4078 PT N = 44859.7018 E = 443880.9198

TOWN OF BENNINGTON

66K

VT. STATE PLANE GRID

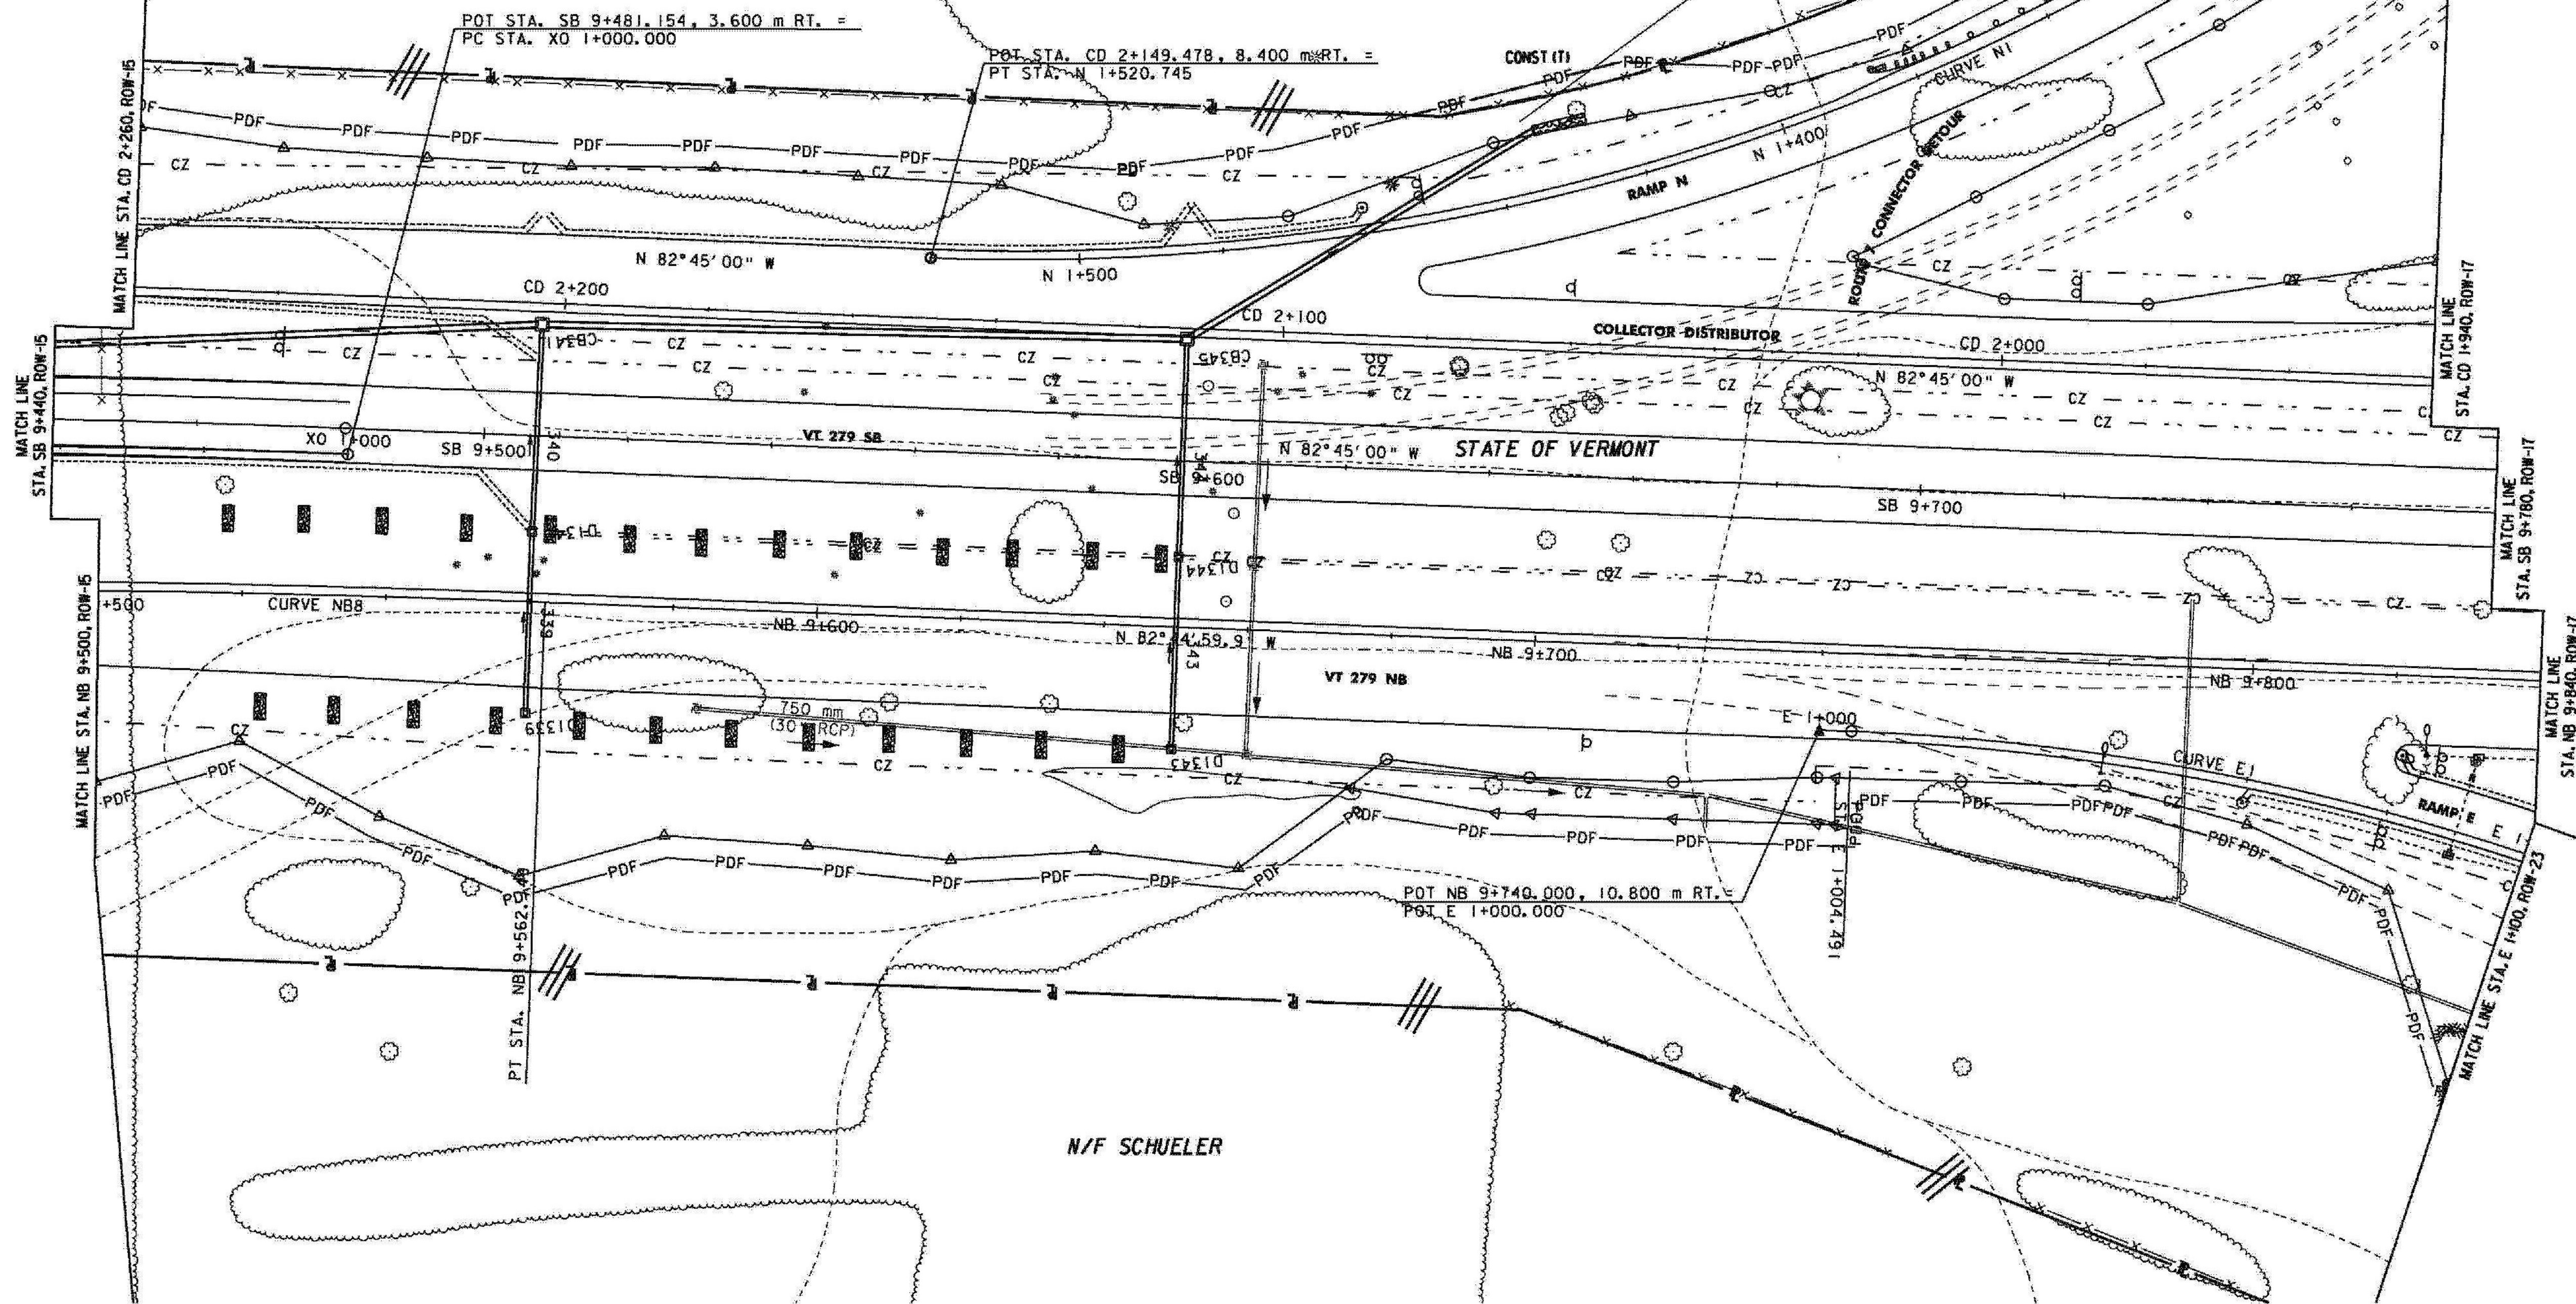

LINES SHOWN ON THIS PLAN AS EXISTING PROPERTY LINES P/L ARE BELIEVED TO BE ACCURATE BUT SHOULD NOT BE RELIED UPON FOR PURPOSES UNRELATED TO THE STATE OF VERMONT'S ACQUISITION OF LAND AND RIGHTS FOR THIS PROJECT.

THIS SHEET TO BE USED FOR RIGHT-OF-WAY INFORMATION ONLY

DATUM
VERTICAL NAVD 88
HORIZONTAL NAD 83 (1992)

0 10 20 30
SCALE 1:500
@ FULL SIZE

**R.O.W.
PLAN
ROW-16**

PROJECT NAME: BENNINGTON	PROJECT NUMBER: NH 019-1(54)
DESIGN FILE NAME: c:\dh\bennington\row	PLOT DATE: 1-25-10
PROJECT LEADER: JDP	DRAWN BY: MBB
	CHECKED BY: GAK
	SHEET: 50 OF 468