STATE OF VERMONT
AGENCY OF TRANSPORTATION

TRAFFIC SIGN SUMMARY SHEET 12

MOT Metric

MILEMARKER, STATION, OR SIGN NUMBER	SIGN LEGEND	SIGN DIMENSIONS EA	WIDTH (mm)	HEIGHT (mm)	NEW & SALVAGED SIGNS "A"	"B"	SALV SIGN	SALV TIS	EXIST POST RETAIN	SALVAGE	NEW SIGN POSTS NO. OF POSTS	SQUARE STEEL (mm) 44 / 50 / 63 kg/m 2.8 / 3.6 / 5.0	ANCHOR	SLEEVE	TUBULAR ALUMINUM dia.(mm) 75 / 100.0 / 100 MOD kg/m 1.9 / 2.5 / 2.5	TUBULAR STEEL dia.(mm) FOUNDATION	75 / 89 / 100 / 125 kg/m 11.3 / 13.4 / 16.1 / 21.8	W-SHAPE STEEL FTG. SIZE 600 mm / 750 mm	WEIGHT	POST SIZE	SIGN REMAINED	REMARKS	SIGN DETAIL DETAIL ON SHEET NUMBER	STD. SHEET NUMBER
U.S. ROUTE 7 NORTHBOUND (CONT.)																							
NB 10+870.0, RT.		1	900	900	0.81	11-9-11					2	9.5 ~~9.9~~ 11-9-11	2										W4-1L, MINIMUM TYPE III SHEETING		SHS
NB 10+965.1, RT.		1	900	300	0.27	11-10-11					1	4.1 ~~4.4~~ 11-10-11	1										R6-1L, MINIMUM TYPE III SHEETING		SHS
062 NB 11+~~025.3~~, LT.	CHANGED 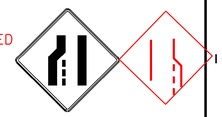	1	900	900	0.81	8-7-12					2	8.8 ~~9.8~~ 8-7-12	2										W4-2L~~~~R, MINIMUM TYPE III SHEETING		SHS
062 NB 11+~~025.3~~, RT.	CHANGED 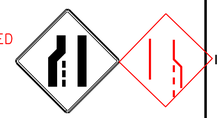	1	900	900	0.81	8-6-12					2	9.1 ~~8.9~~ 8-6-12	2										W4-2L~~~~R, MINIMUM TYPE III SHEETING		SHS
U.S. ROUTE 7 SOUTHBOUND SB 9+810.4, LT.		1	900	300	0.27	8-2-12					1	4.1 ~~4.3~~ 8-2-12	1										R6-1L, MINIMUM TYPE III SHEETING		SHS
SB 9+900.0, LT.		1	900	900	0.81	8-1-12					2	8.6 ~~10.1~~ 8-1-12	2										W4-3L, MINIMUM TYPE III SHEETING		SHS
SB 9+990.0, LT.		1 1	750 900	375 900	0.28 0.81	8-13-12					1	4.8 ~~5.4~~ 8-13-12	1										M3-3, MINIMUM TYPE III SHEETING M1-4, MINIMUM TYPE III SHEETING		SHS SHS
SHEET TOTALS		m² 4.87	m² 0	EA.	m²							m 0 / ~~47.4~~ 44.2 / ~~5.4~~ 4.8	EA	kg	kg	kg	kg	kg	kg	kg	kg	kg	kg	kg	kg
												m ~~52.8~~ 49.0		kg			EA.	kg			EA.	EA.	kg

SHS = STANDARD HIGHWAY SIGNS MANUAL

NOTES:

1. FINAL POST LENGTHS ARE TO BE DETERMINED IN THE FIELD. POST SIZES ARE COMPUTED BASED ON INFORMATION FURNISHED ON THE STANDARD SHEETS AND THE VTRANS "SIGN POST DESIGN GUIDELINE."

2. ALL OVERHEAD GUIDE SIGNS SHALL HAVE A MINIMUM TYPE IX LEGEND ON TYPE IX BACKGROUND. ALL GROUND MOUNTED GUIDE SIGNS SHALL HAVE A MINIMUM TYPE IX LEGEND ON TYPE III BACKGROUND. ALL CHEVRON SIGNS SHALL HAVE TYPE IX SHEETING. ALL OTHER GROUND MOUNTED SIGNS SHALL HAVE A MINIMUM TYPE III SHEETING.

Stantec

PROJECT NAME: BENNINGTON
PROJECT NUMBER: NH 019-1(54)

FILE NAME: ...\plot_files\zd307c4tss.ptf
DESIGN SUPERVISOR: GREG EDWARDS
DESIGNED BY: MARC FOISY
TRAFFIC SIGN SUMMARY SHEET TSS-12

PLOT DATE: 1/26/2010
DRAWN BY: STANTEC
CHECKED BY: GARY SANTY
SHEET 197 OF 468

1/26/2010 4:51:21 PM v:\1853\active\18530002\transportation\drawing\contract 4\plot_files\zd307c4tss.ptf