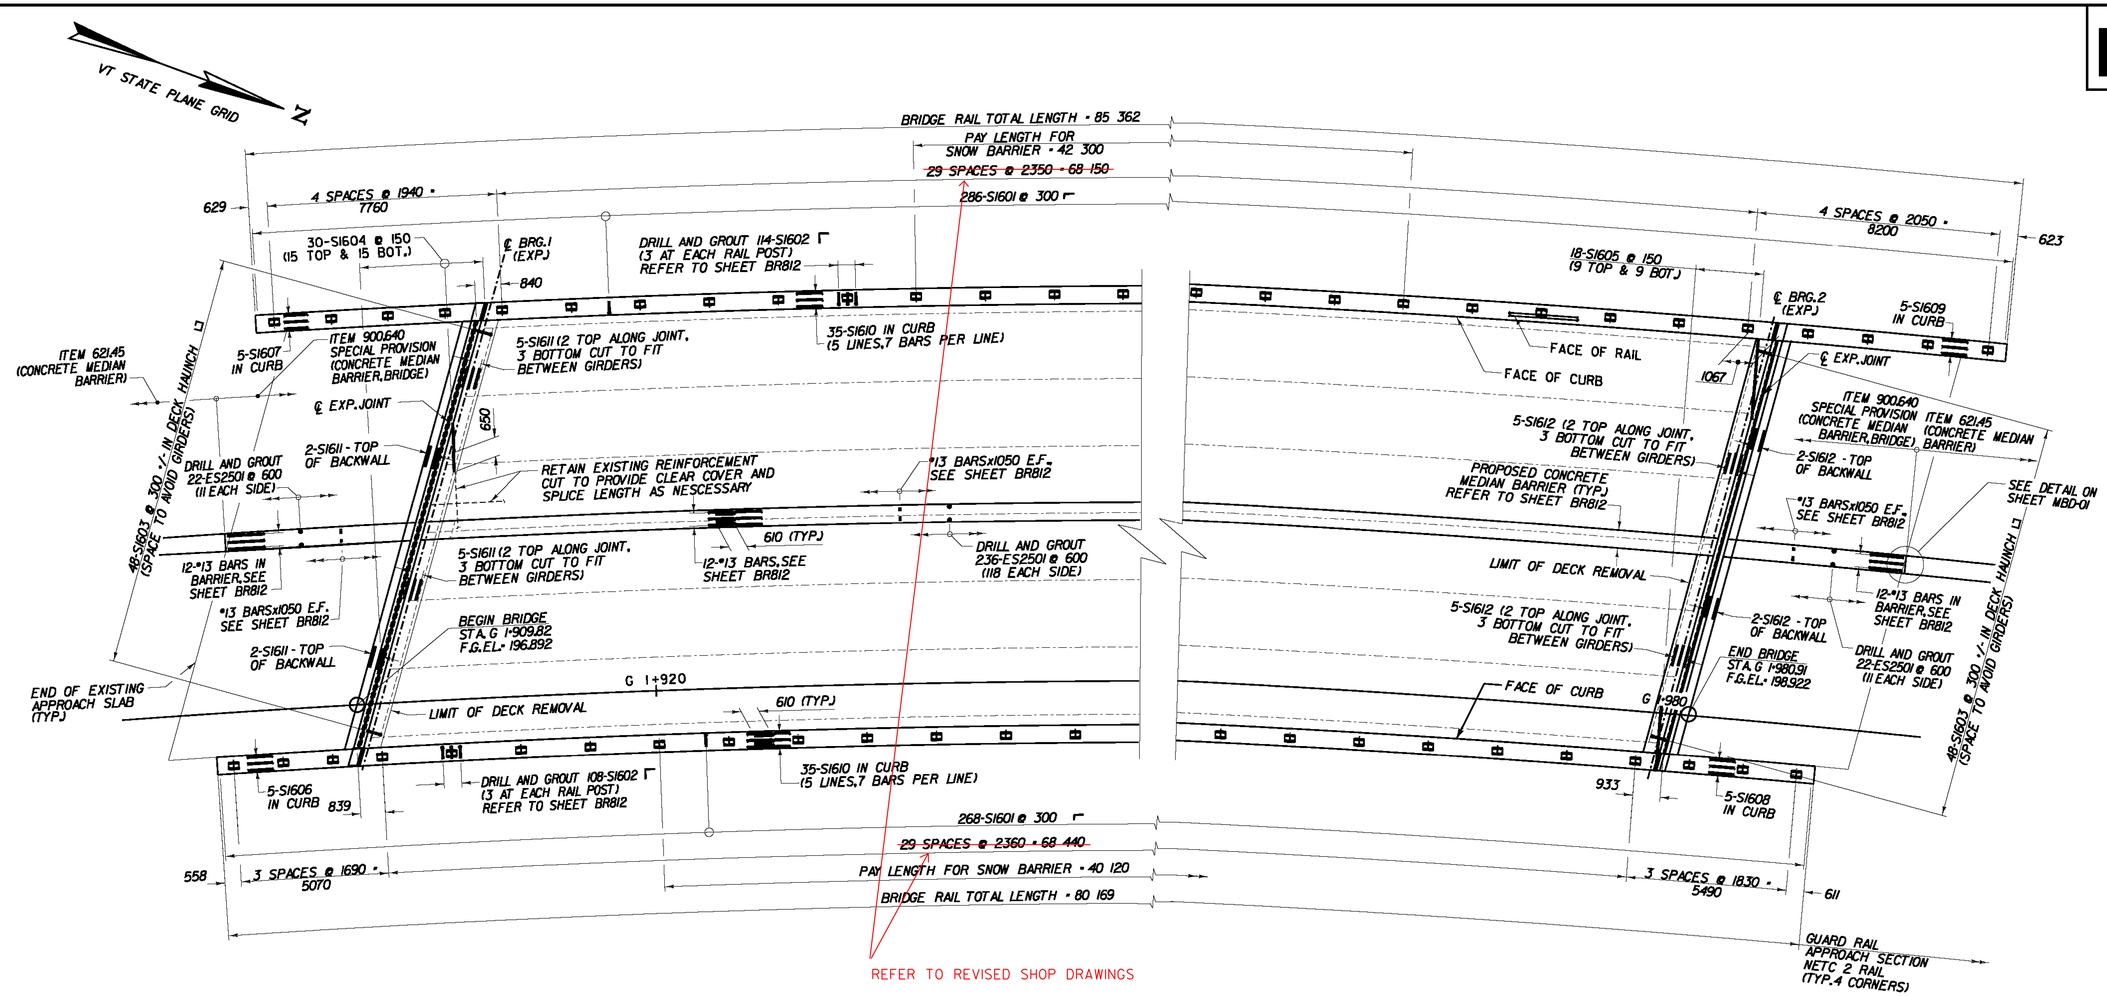

NOTE: ALL DIMENSIONS RADIAL, ALONG FACE OF RAIL

REINFORCEMENT AND RAILING PLAN

0 2 4 6 8 10

SCALE 1:100

STATE OF VERMONT
AGENCY OF TRANSPORTATION

Town Of BENNINGTON	Bridge No. 14A
Highway No.	Log Sta. / Surv. Sta.
RAMP G/S OVER VT ROUTE 279 WB	
REINFORCEMENT AND RAILING PLAN	
Designed By E. ALLING	Drawn By T.KNIGHT
Checked By M. CHENETTE Date 11/09	Bridge Design Supervisor G. BOGUE Date 11/09
PROJECT BENNINGTON	PROJECT NO. NH F019-1(54)
Stantec	L.G.C. Info:
Bridge Sheet No. BR813	Sheet 288 of 468

1/26/2010 4:54:56 PM v:\1953\active\195310002\structural\design\st7\plot files\813-S1RAMPES-Rail.pt f