Metric

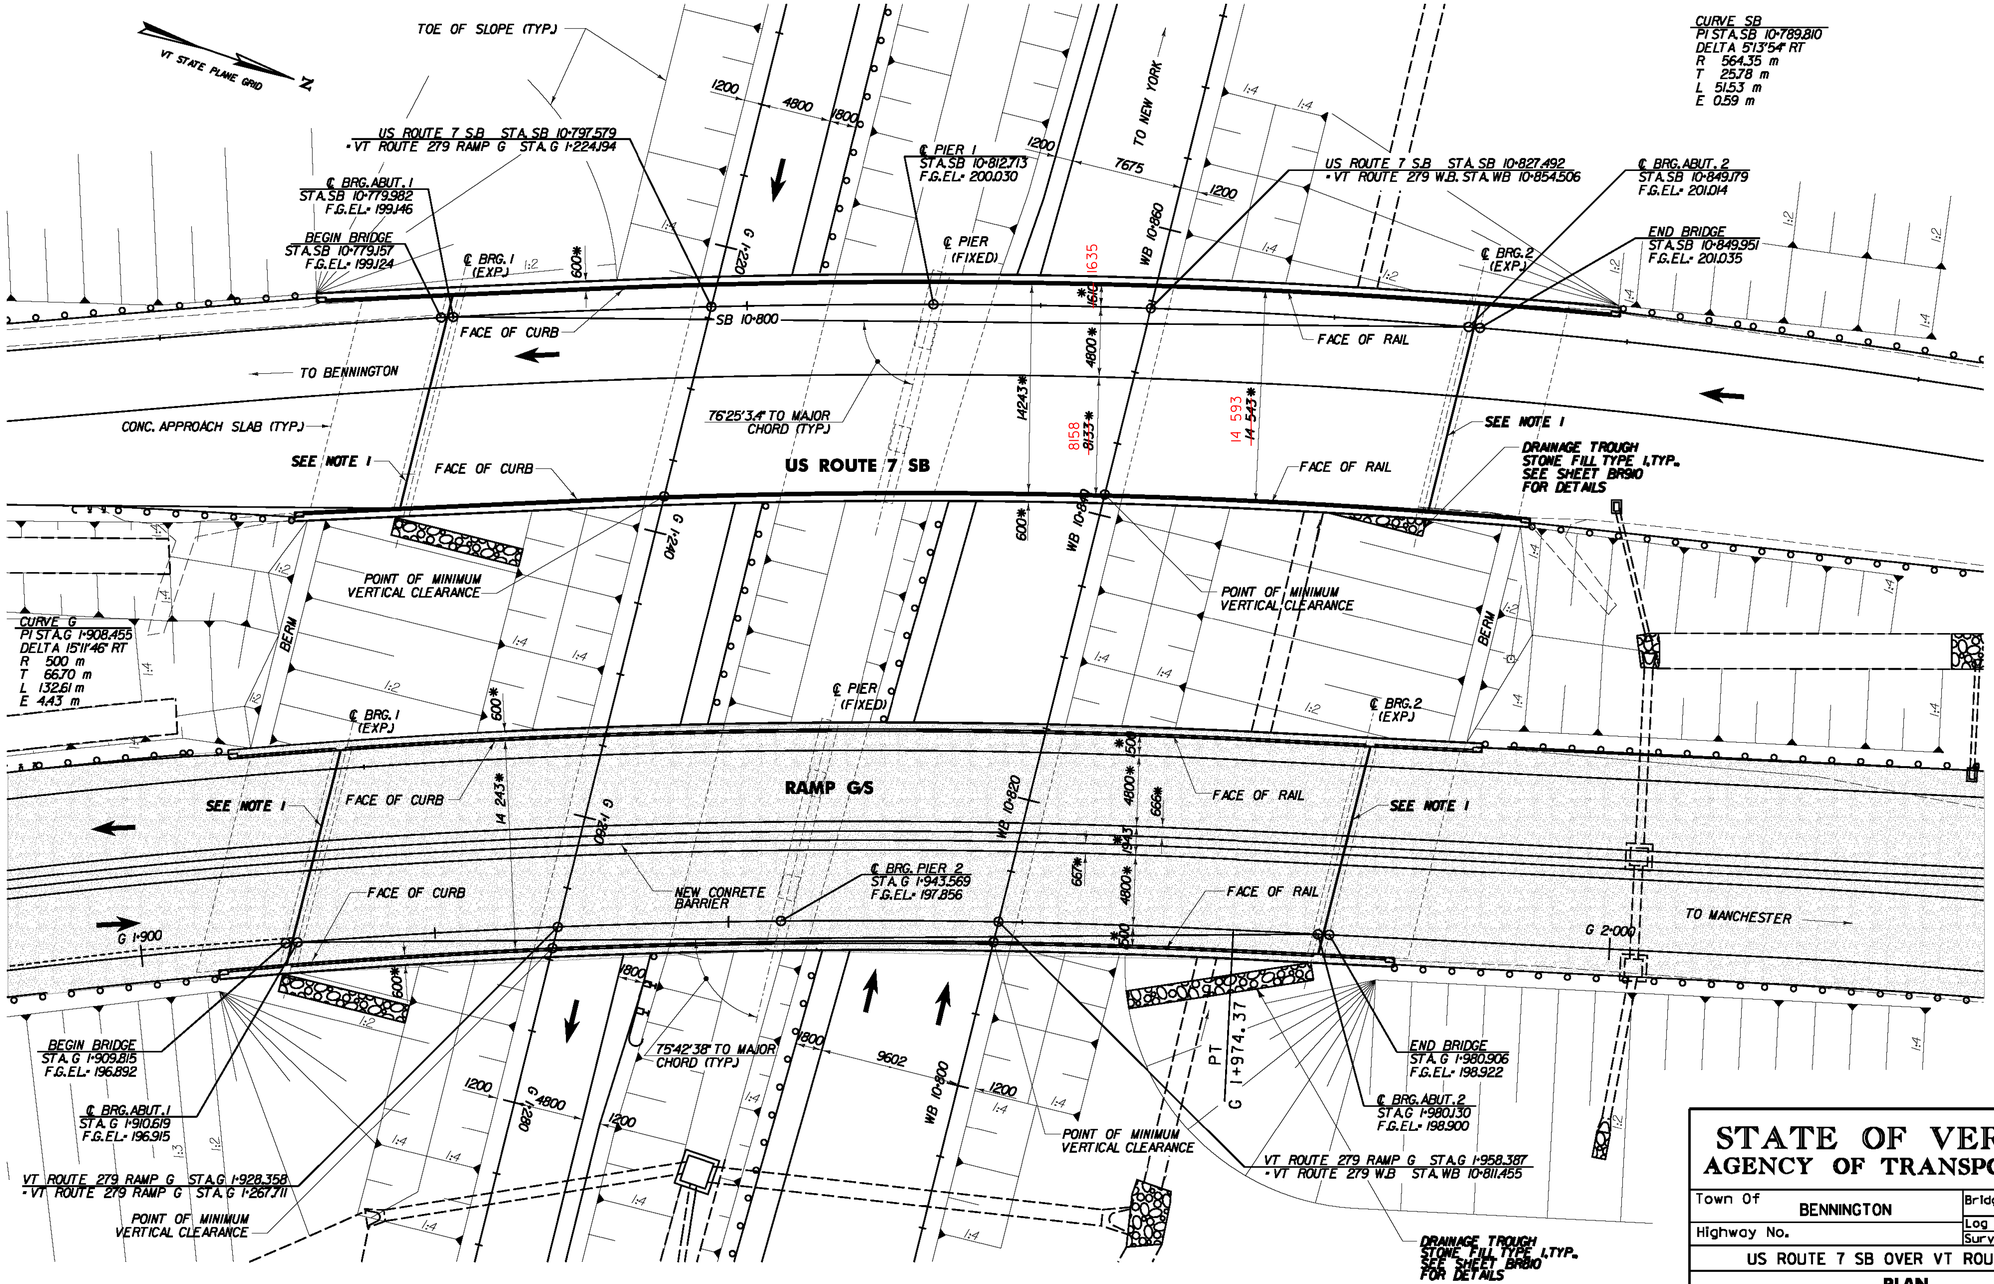

PLAN

0 4 8 12 16 20

SCALE 1:200

NOTES:

1. EXISTING BRIDGE EXPANSION JOINTS TO BE REPLACED WITH VERMONT JOINTS.

* - INDICATES RADIAL DIMENSION.

STATE OF VERMONT
AGENCY OF TRANSPORTATION

Town Of BENNINGTON	Bridge No. 14S
Highway No.	Log Sta.
	Surv. Sta.
US ROUTE 7 SB OVER VT ROUTE 279 WB	
PLAN	
Designed By M. CHENETTE	Drawn By A. THIBAULT
Checked By M. CHENETTE Date 11/09	Bridge Design Supervisor G. BOGUE Date 11/09
PROJECT BENNINGTON	PROJECT NO. NH F019-1(54)
I.G.C. Info:	
Bridge Sheet No. BR903	Sheet 297 of 468

Stantec

3/17/2010 11:35:58 PM v:\1953\active\195310002\structural\design\s17\plot Files\903-S17SB-Plan.prf