Metric

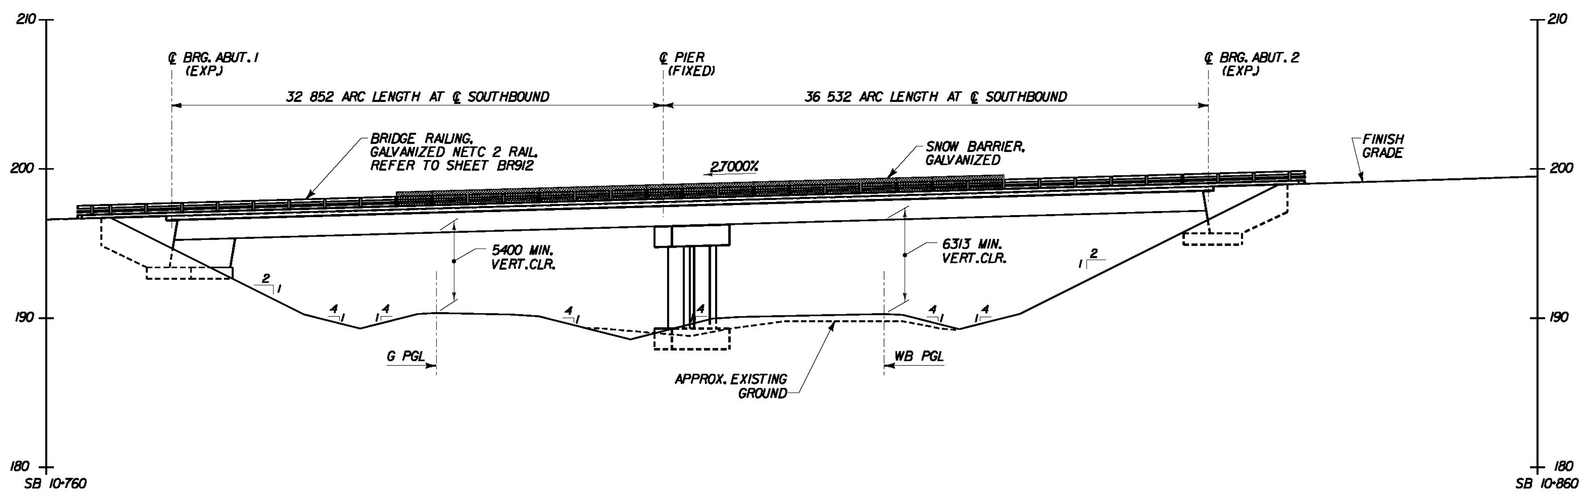

ELEVATION

0 4 8 12 16 20

SCALE 1:200

STATE OF VERMONT
AGENCY OF TRANSPORTATION

Town Of BENNINGTON	Bridge No. 14S
Highway No.	Log Sta. / Surv. Sta.
US ROUTE 7 SB OVER VT ROUTE 279 WB	
ELEVATION	
Designed By M. CHENETTE	Drawn By J. SOTER
Checked By M. CHENETTE Date 11/09	Bridge Design Supervisor G. BOGUE Date 11/09
PROJECT BENNINGTON	PROJECT NO. NH F019-1(54)
L.G.C. Info:	
Bridge Sheet No. BR904	Sheet 298 of 468

Stantec

1/26/2010 4:55:23 PM v:\1953\active\195310002\structural\design\sl7\plot files\904-S175B-ELEV.pt f