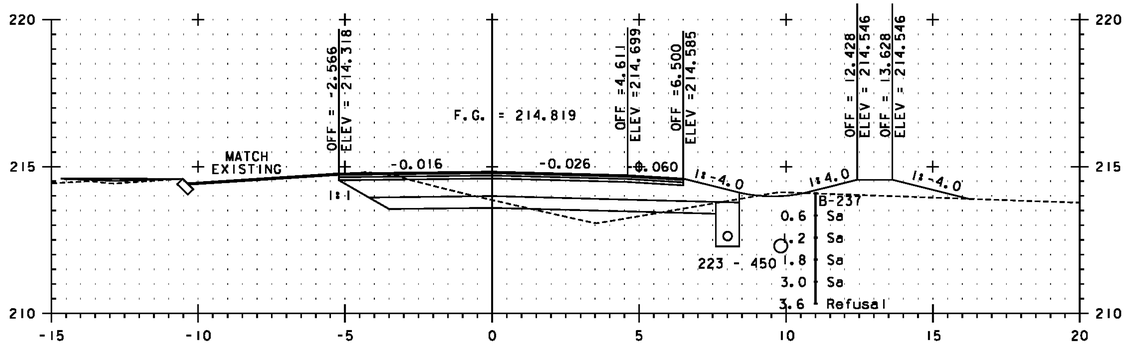

WB 10+060

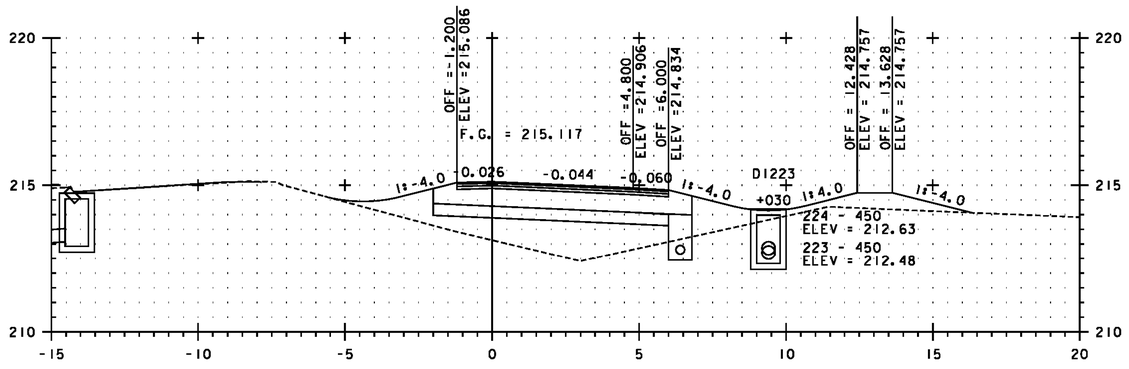

WB 10+040

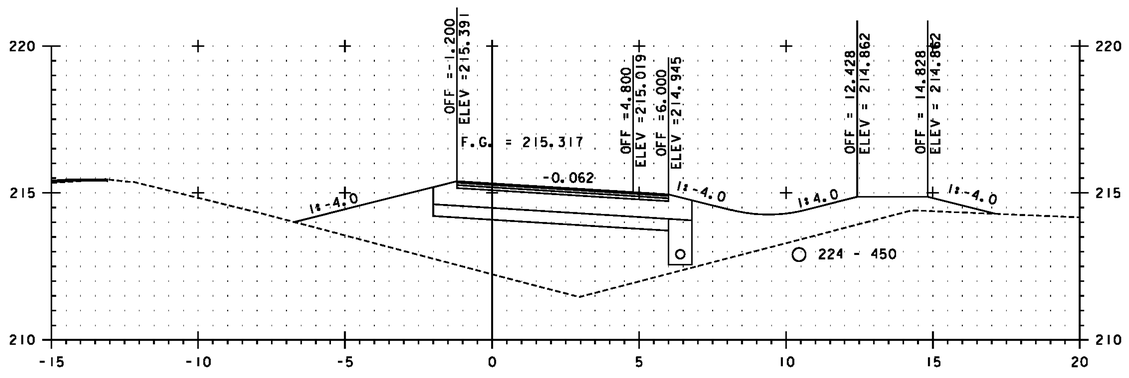

WB 10+020

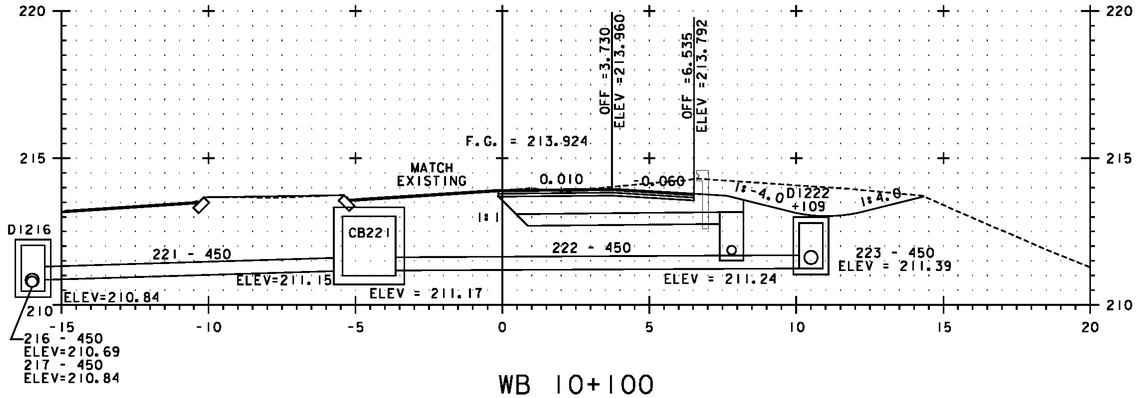

WB 10+100

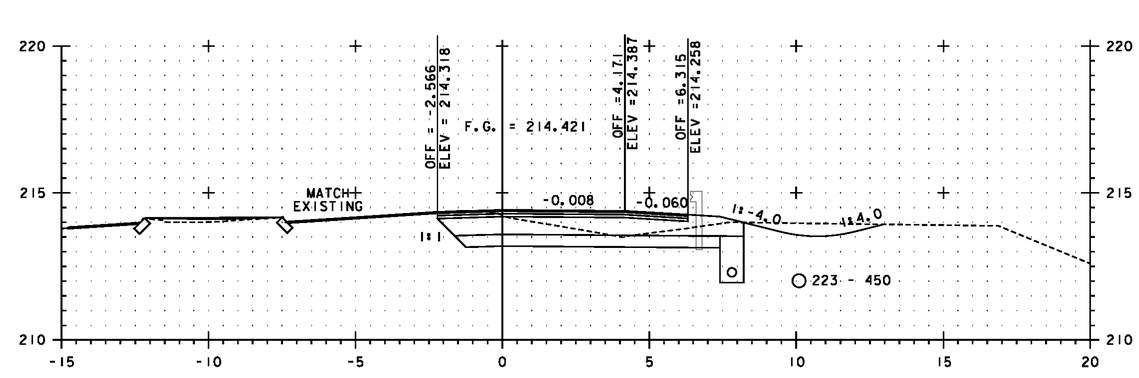

WB 10+080

SEE NOTE ON SHEET 312

SEE REVISED

5 METERS
H 1:100 SCALE
V 1:100 SCALE
@ FULL SIZE
2.5
2.5 5 METERS

Stantec

PROJECT NAME: BENNINGTON
PROJECT NUMBER: NH 019-1(54)

FILE NAME: ...\plot_files\zd307c4xs_279WB.ptf PLOT DATE: 1/26/2010
DESIGN SUPERVISOR: GREG EDWARDS DRAWN BY: STANTEC
DESIGNED BY: MARC FOISY CHECKED BY: GARY SANTY
VT 279 WB CROSS SECTION WBX-13 SHEET 324 OF 468

1/26/2010 4:56:07 PM v:\1953\active\195310002\transportation\drawing\contract 4\plot_files\zd307c4xs_279WB.ptf