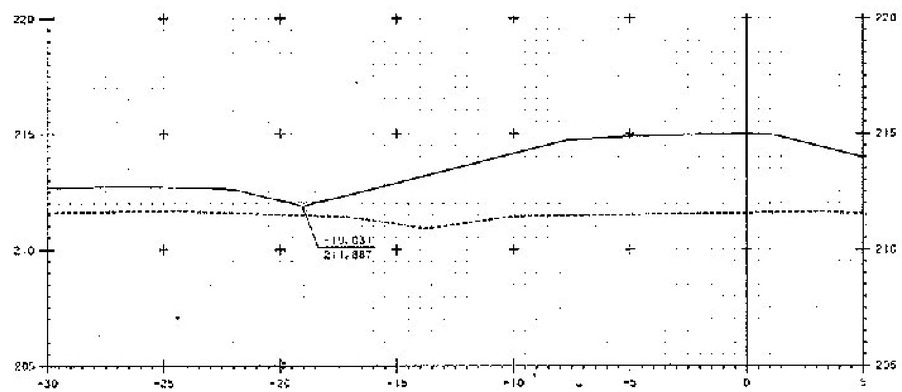

F 1+100

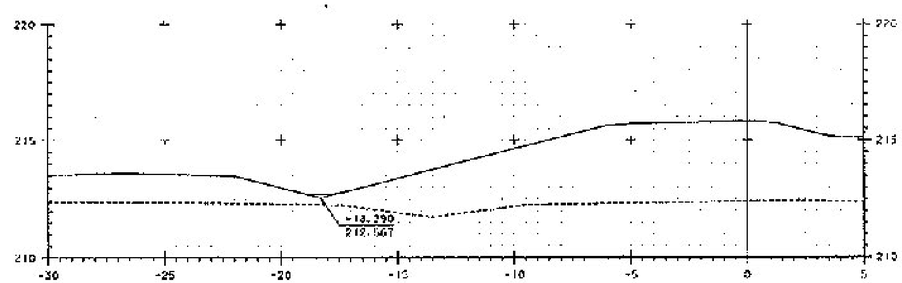

F 1+080

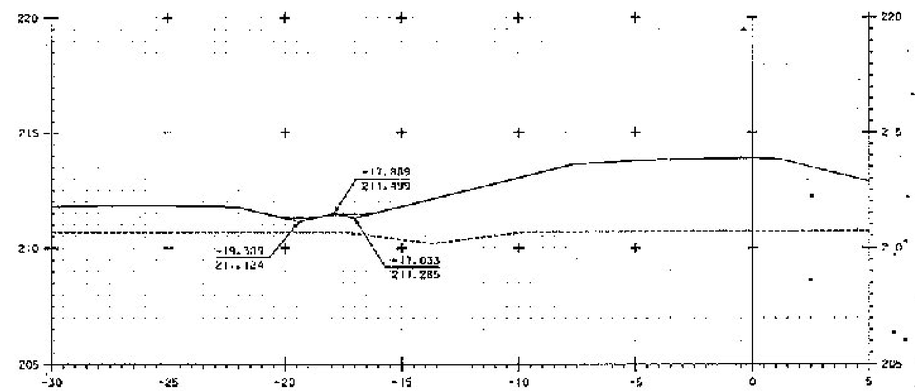

F 1-120

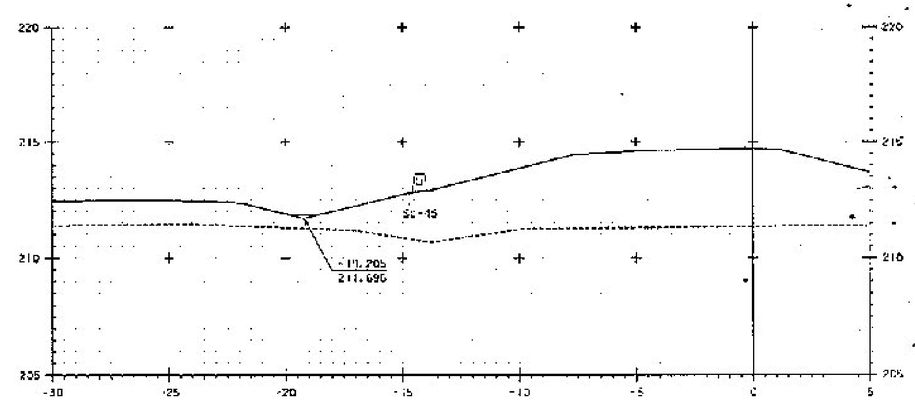

F 1+105.368

LIGHT POLE
RECORD RUNS