10/3/2012

- - - - - - - - Original Ground

———————— Shanten Design

- - - - - - - - C54 Final Survey

/////// 203.15 Common Excavation

10.078 SM

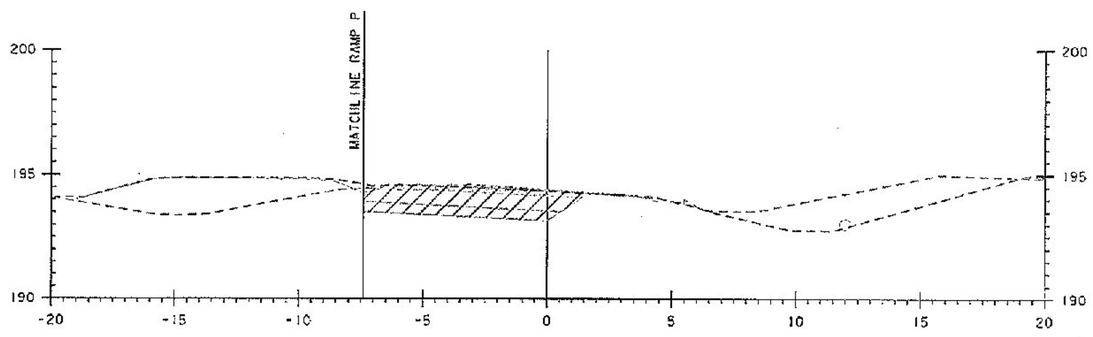

℄ 1+020.000

Bennington AC NH 019-1(54)
Ramp Q Common Excavation
October XX, 2012
Calculated by GPI
Scale 1:200

Checked By:

Revised

E:\2007\2037035.00 Bennington Bypass\Bennington Bypass\Centerset 54\Ramp Q\Ramp Q Common Ex 10-XX-12.dgn