Metric

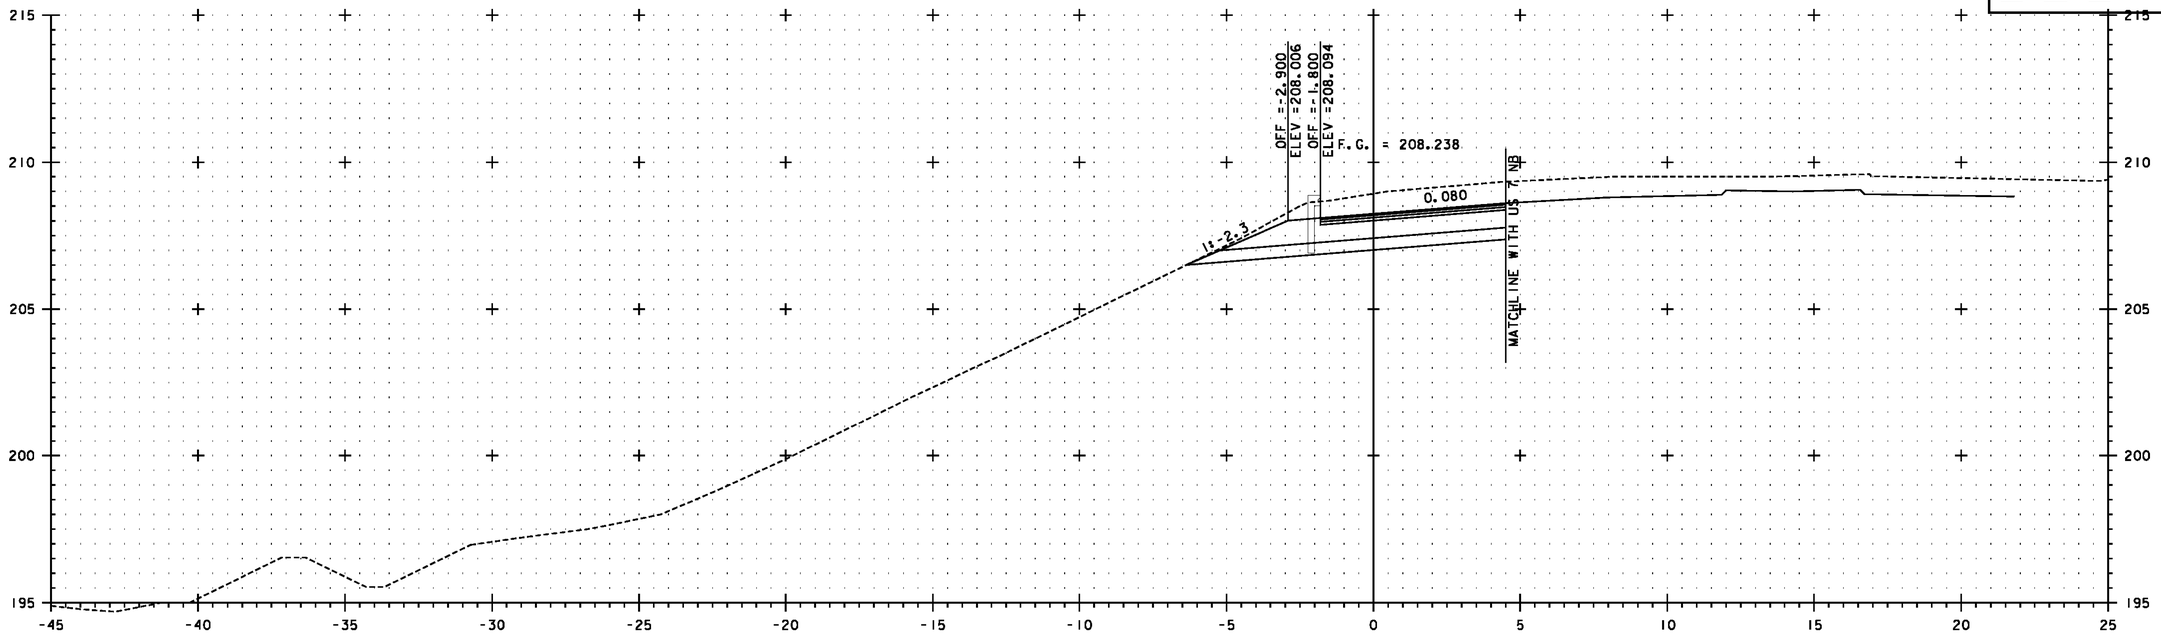

SB 9+800

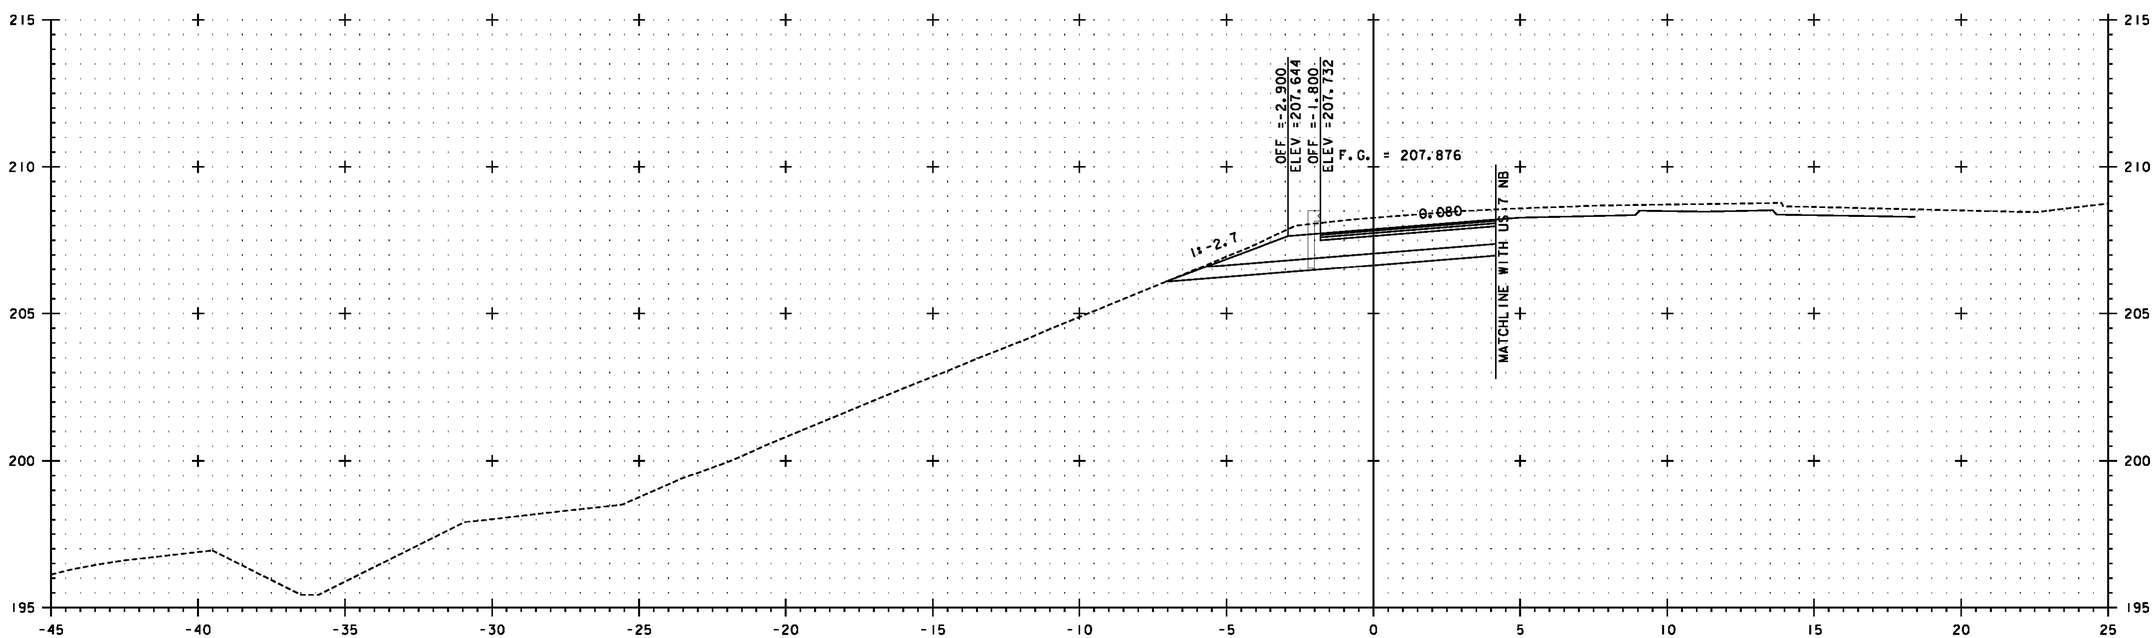

SB 9+780

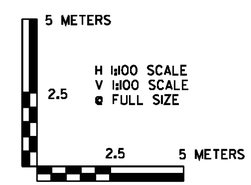

SEE NOTE ON
SHEET 447

Stantec

PROJECT NAME: BENNINGTON
PROJECT NUMBER: NH 019-1(54)

FILE NAME: ...\plot_files\zd307c4xs_7SB.ptf
DESIGN SUPERVISOR: GREG EDWARDS
DESIGNED BY: MARC FOISY
US 7 SB CROSS SECTION SBX-02

PLOT DATE: 1/26/2010
DRAWN BY: STANTEC
CHECKED BY: GARY SANTY
SHEET 448 OF 468

1/26/2010 4:58:44 PM v:\1953\active\195310002\transportation\drawing\contract 4\plot_files\zd307c4xs_7SB.ptf