RECORD PLANS

6

SIGN POST DESIGN FOR TYPE "B" GROUND DETAIL #2 US 7 NB STA. 9+410, RT.

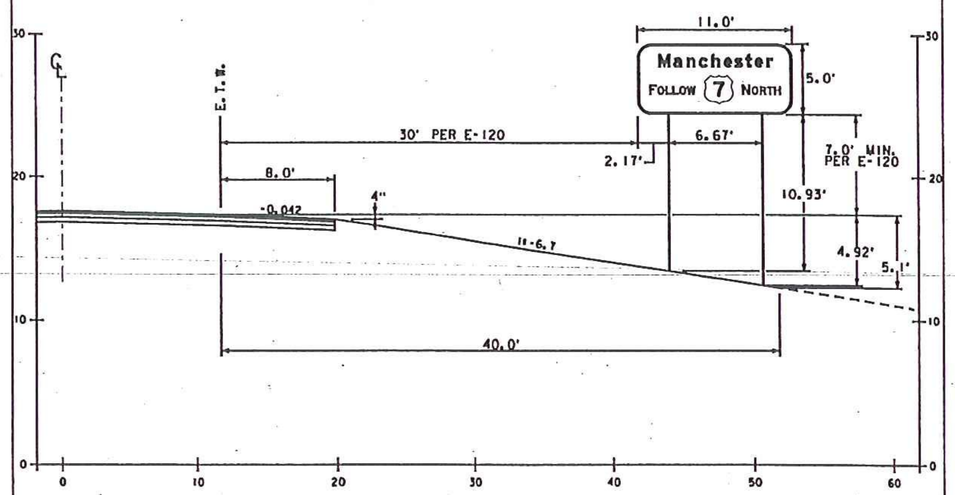

SELECTED W6X12 POSTS

WIDTH x HEIGHT = AREA
A= 11.0x 5.0' = 55.00 SF

OVERALL LENGTH x Lbs./FT = Lbs.

~~(5'+10.93'+5'+7'+4.92')~~ x 12 = ~~394.20 Lbs.~~ = 178.8Kg

17.5'+16.5'= 34'x12 = 408 lbs = 185kg

2' FOOTING SIZE (SEE VTrans STD. E-161)

600mm