VT 67A MM 0.25, RT

SIGN DETAIL
1:10

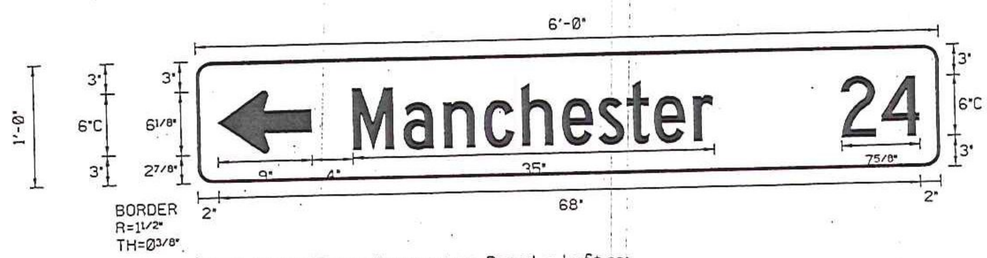

Panel Style: VTrans Destination Board - Left.ssl
M.U.T.C.D.: 2003 Edition

Panel Style: VTrans Destination Board - Left.ssl
Dimensions are in inches eighths

Letter locations are panel edge to lower left corner

SIGN NUMBER	Vtrans Destination Board - Left
WIDTH x HGHT.	6'-0" x 1'-0"
BORDER WIDTH	0**
CORNER RADIUS	1**
MOUNTING	Overhead
BACKGROUND	TYPE: Reflective
	COLOR: Green
LEGEND/BORDER	TYPE: Reflective
	COLOR: White/White

SYMBOL	ROT	X	Y	WID	HT
ARUP	90	2"	2 7/8"	6 1/8"	9"

LETTER POSITIONS (X)

M	a	n	. c	h	e	s	t	e	r	LENGTH	SERIES/SIZE
15"	19 7/8"	23 3/4"	27 5/8"	31 3/8"	35 1/4"	39 7/8"	41 5/8"	44 1/8"	48"		C 2000
										35"	04 1/2"
											C 2000
2	.4									7 5/8"	6
62 3/8"	66 1/4"										

RECORD PLANS

10