VT 67A MM 0.38, LT

SIGN DETAIL
1:10

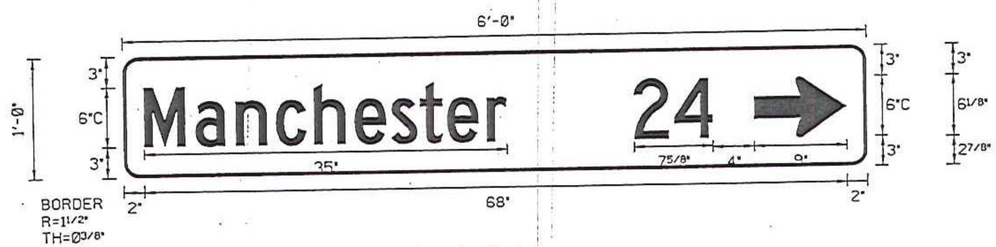

SIGN NUMBER	Vtrans – Destination Board Right
WIDTH x HGHT.	6'-0" x 1'-0"
BORDER WIDTH	0""
CORNER RADIUS	1""
MOUNTING	Overhead
BACKGROUND	TYPE: Reflective
	COLOR: Green
LEGEND/BORDER	TYPE: Reflective
	COLOR: White/White

SYMBOL	ROT	X	Y	WID	HT
ARUP	270	61"	2 7/8"	6 1/8"	9"

Panel Style: VTrans Destination Board – Right.ssl
Dimensions are in Inches eighths

Panel Style: VTrans Destination Board - Right.ssl
M.U.T.C.D.: 2003 Edition

Letter locations are panel edge to lower left corner

LETTER POSITIONS (X)

M	a	n	c	h	e	s	t	e	r	LENGTH	SERIES/SIZE
											C 2000
2"	6 7/8"	10 3/4"	14 5/8"	18 3/8"	22 1/8"	25 7/8"	28 5/8"	31 1/8"	35"	35"	6/4 1/2"
											C 2000
2	4									7 5/8"	6
48 3/8"	53 1/4"										

RECORD PLANS