SIGN DETAIL
1:10

VT 9 STA. 1+590.0, LT

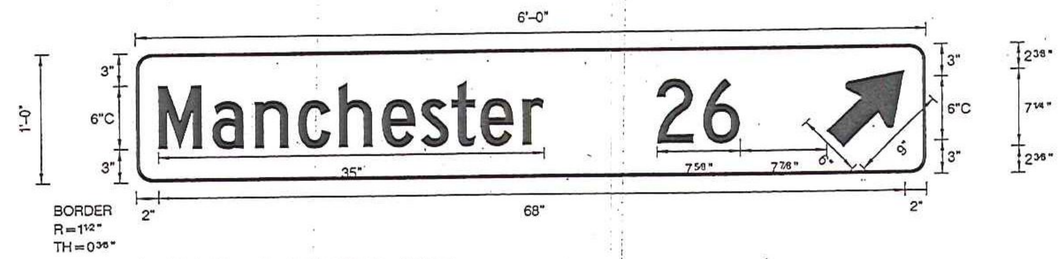

Panel Style: VTrans Destination Board – Right.ssl
M.U.T.C.D.: 2003 Edition

Panel Style: VTrans Destination Board – Right.ssl
Dimensions are In Inches eighths

Letter locations are panel edge to lower left corner

SIGN NUMBER	Vtrans Destination Board – Angle Rig				
WIDTH x HGHT.	6'-0" x 1'-0"				
BORDER WIDTH	0""				
CORNER RADIUS	1""				
MOUNTING	Overhead				
BACKGROUND	TYPE: Reflective				
	COLOR: Green				
LEGEND/BORDER	TYPE: Reflective				
	COLOR: White/White				

SYMBOL	ROT	X	Y	WID	HT
ARUP	31 3/4"	62 7/8"	2 3/8"	6"	9"

LETTER POSITIONS (X)

M	a	n	c	h	e	s	t	e	r	LENGTH	SERIES/SIZE
2"	6 7/8"	10 3/4"	14 5/8"	18 3/8"	22 1/4"	25 7/8"	28 5/8"	31 1/8"	35"	35"	C 2000 64 1/2"
2	6									7 5/8"	C 2000 6
47 3/8"	51 5/8"										

RECORD PLANS

15