DIRECTION	MILEPOINT	LOCATION CODE (SHEET 2)	SIGN CODE	WIDTH (MM)	HEIGHT (MM)	SHEETING REMARKS	SIGN LEGEND	NEW SIGNS "A"	NEW SIGNS "B"	EXISTING SIGNS RETAIN	EXISTING SIGNS SALVAGE FROM	EXISTING SIGNS SALVAGE TO	EXISTING SIGNS REMOVE	EXIST POST RETAIN	EXIST POST REMOVE	NUMBER OF NEW POSTS	SQUARE STEEL (MM) (KG /M) 44 / 2.8	SQUARE STEEL (MM) (KG /M) 50 / 3.2	SQUARE STEEL (MM) (KG /M) 63 / 5.0	TUBULAR STEEL Ø (mm) (KG /M) FOUNDATION	TUBULAR STEEL Ø (mm) (KG /M) 75 / 11.30	TUBULAR STEEL Ø (mm) (KG /M) 89 / 13.40	TUBULAR STEEL Ø (mm) (KG /M) 100 / 16.10	TUBULAR STEEL Ø (mm) (KG /M) 125 / 21.70	SIGN FRAME REQUIRED	REMARKS	SIGN DETAIL LOCATION SHSM	SIGN DETAIL LOCATION PROJECT SHEET #	SIGN DETAIL LOCATION STANDARD SHEET #
BENNINGTON US7							FY-FLUORESCENT YELLOW FYG-FLUORESCENT YELLOW GREEN																		"SHSM"-STANDARD HIGHWAY SIGNS AND MARKINGS			
NB	3.910	J	R4-7	600	750		9-18-12	0.45								1	4.0 ~~X~~ 9-18-12										X		
		J	OM1-1	450	450			0.20									9-18-12										X		
NB	3.935 Lt	A	W3-3	900	900		SIGNAL AHEAD Old+New 9-18-12	0.81		1			1	~~X~~	X	2	8.7 ~~X~~			Existing Removed Lea. 9-18-12					Poor Condition-Replaced ~~RETAIN IF IN GOOD CONDITION~~			
NB	3.935 Rt	J	W3-3	900	900		SIGNAL AHEAD 9-19-12	0.81		1			1		X		Post Retained			Existing Panel Removed Lea. 9-19-12					Poor Condition-Replaced ~~RETAIN IF IN GOOD CONDITION~~			
NB	3.98	A	M3-1	600	300		NORTH						1		X														
		A	M1-5A	600	600		HISTORIC 7A						1																
		A	M6-1	525	375		LEFT ARROW 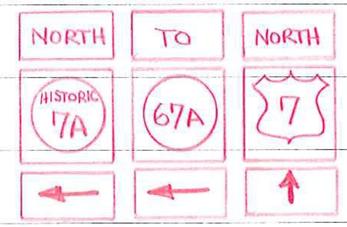						1							Existing Removed Lea. 9-19-12								
		A	M4-5	600	300		TO						1																
		A	M1-5A	600	600		VT 67A						1																
		A	M6-1L	525	375		LEFT ARROW						1																
		A	M3-1	600	300		NORTH						1																
		A	M1-4	600	600		US 7						1																
		A	M6-3	525	375		UP ARROW 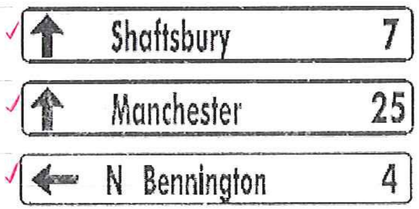						1																
		A	VD1-1A	1800	300			0.54 9-11-12								2	8.8 ~~X~~ 9-11-12										2		
		A	VD1-1A	1800	300			0.54																			2		
							SHEET TOTALS	1.73 SM	0.00 SM	2 EA	0 EA	0 EA	9 EA	2 EA	1 EA	3 EA	13.8 M		0 EA	0.0 KG	0.0 KG	0.0 KG	0.0 KG						
							TOWN DIRECTIONAL TOTALS	43.67	2.25	3	0	0	53	5	28	57	262.2		2		104.0								

SIGN SUMMARY SHEET

VERMONT AGENCY OF TRANSPORTATION

RECORD PLANS

PROJECT NAME: Bennington
PROJECT NUMBER: NH 019-1(54)
FILE NAME: Bennington US7.xls
PROJECT MANAGER: 0
DESIGNED BY: T. Guazzoni
BENNINGTON US7 SHEET 2
PLOT DATE: 3/7/2012
DRAWN BY: T. Guazzoni
CHECKED: 0
SHEET 2 OF 10