RECORD PLANS

DIRECTION	MILEPOINT	LOCATION CODE (SHEET 2)	SIGN CODE	WIDTH (MM)	HEIGHT (MM)	SHEETING REMARKS	SIGN LEGEND	NEW SIGNS "A"	NEW SIGNS "B"	EXISTING SIGNS RETAIN	EXISTING SIGNS SALVAGE FROM	EXISTING SIGNS SALVAGE TO	EXISTING SIGNS REMOVE	EXIST POST RETAIN	EXIST POST REMOVE	NUMBER OF NEW POSTS	SQUARE STEEL (MM) 44 (KG /M) 2.8	SQUARE STEEL (MM) 50 (KG /M) 3.2	SQUARE STEEL (MM) 63 (KG /M) 5.0	FOUNDATION	TUBULAR STEEL Ø (mm) 75 (KG /M) 11.30	TUBULAR STEEL Ø (mm) 89 (KG /M) 13.40	TUBULAR STEEL Ø (mm) 100 (KG /M) 16.10	TUBULAR STEEL Ø (mm) 125 (KG /M) 21.70	SIGN FRAME REQUIRED	REMARKS	SIGN DETAIL LOCATION SHSM	SIGN DETAIL LOCATION PROJECT SHEET #	SIGN DETAIL LOCATION STANDARD SHEET #
BENNINGTON US7							FY-FLUORESCENT YELLOW FYG-FLUORESCENT YELLOW GREEN																		"SHSM"-STANDARD HIGHWAY SIGNS AND MARKINGS			
		A	VD1-1A	1800	300			0.54																				2	
NB	4.018	A	M3-1	600	300			0.18								2			9.3 ~~X~~						3	GREEN ON WHITE	X		
		A	VM-078	600	300			0.18									9-19-12									GREEN ON WHITE "HISTORIC"		2	
		A	M1-5	600	600			0.36																					E-136B
		A	M6-1L	525	375			0.20																		GREEN ON WHITE	X		
		A	M4-5	600	300		9-19-12	0.18																		GREEN ON WHITE	X		
		A	M1-5A	600	600		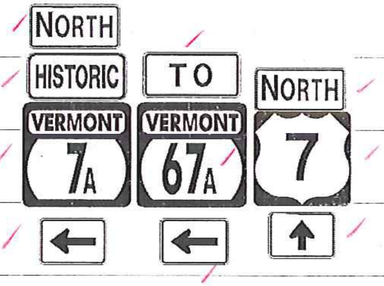	0.36																					E-136B
		A	M6-1L	525	375			0.20																		GREEN ON WHITE	X		
		A	M3-1	600	300			0.18																		BLACK ON WHITE	X		
		A	M1-4	600	600			0.36																			X		
		A	M6-3	525	375			0.20																		BLACK ON WHITE	X		
NB	4.025	A	VR-941	1500	750		LEFT "ONLY"/THRU/THRU/RIGHT "ONLY"			1				X															
NB	4.075	A	VR-941	1500	750		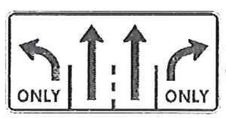 9-11-12					1		X							Existing Removed 1 ea 9-11-12							
		A	VR-941	1500	750			1.13								2			8.6 ~~X~~ 9-11-12										E-145A
NB	4.135	A	R3-7R	750	750		"RIGHT LANE MUST TURN RIGHT" (See Next Sheet)					1		~~X~~ X							Existing Removed 1 ea					Post Removed & Replaced		
							SHEET TOTALS	4.06 SM	0.00 SM	1 EA	0 EA	0 EA	2 EA	2 EA	1 EA	4 EA			18.4 M		0 EA	0.0 KG	0.0 KG	0.0 KG	0.0 KG					
							TOWN DIRECTIONAL TOTALS	43.67	2.25	3	0	0	58	5	28	57			262.2		2		104.0						

SIGN SUMMARY SHEET

VERMONT AGENCY OF TRANSPORTATION

PROJECT NAME: Bennington
PROJECT NUMBER: NH 019-1(54)
FILE NAME: Bennington US7.xls
PROJECT MANAGER: 0
DESIGNED BY: T. Guazzoni
BENNINGTON US7 SHEET 3
PLOT DATE: 3/7/2012
DRAWN BY: T. Guazzoni
CHECKED 0
SHEET 3 OF 10