3/21/2012

RECORD PLANS

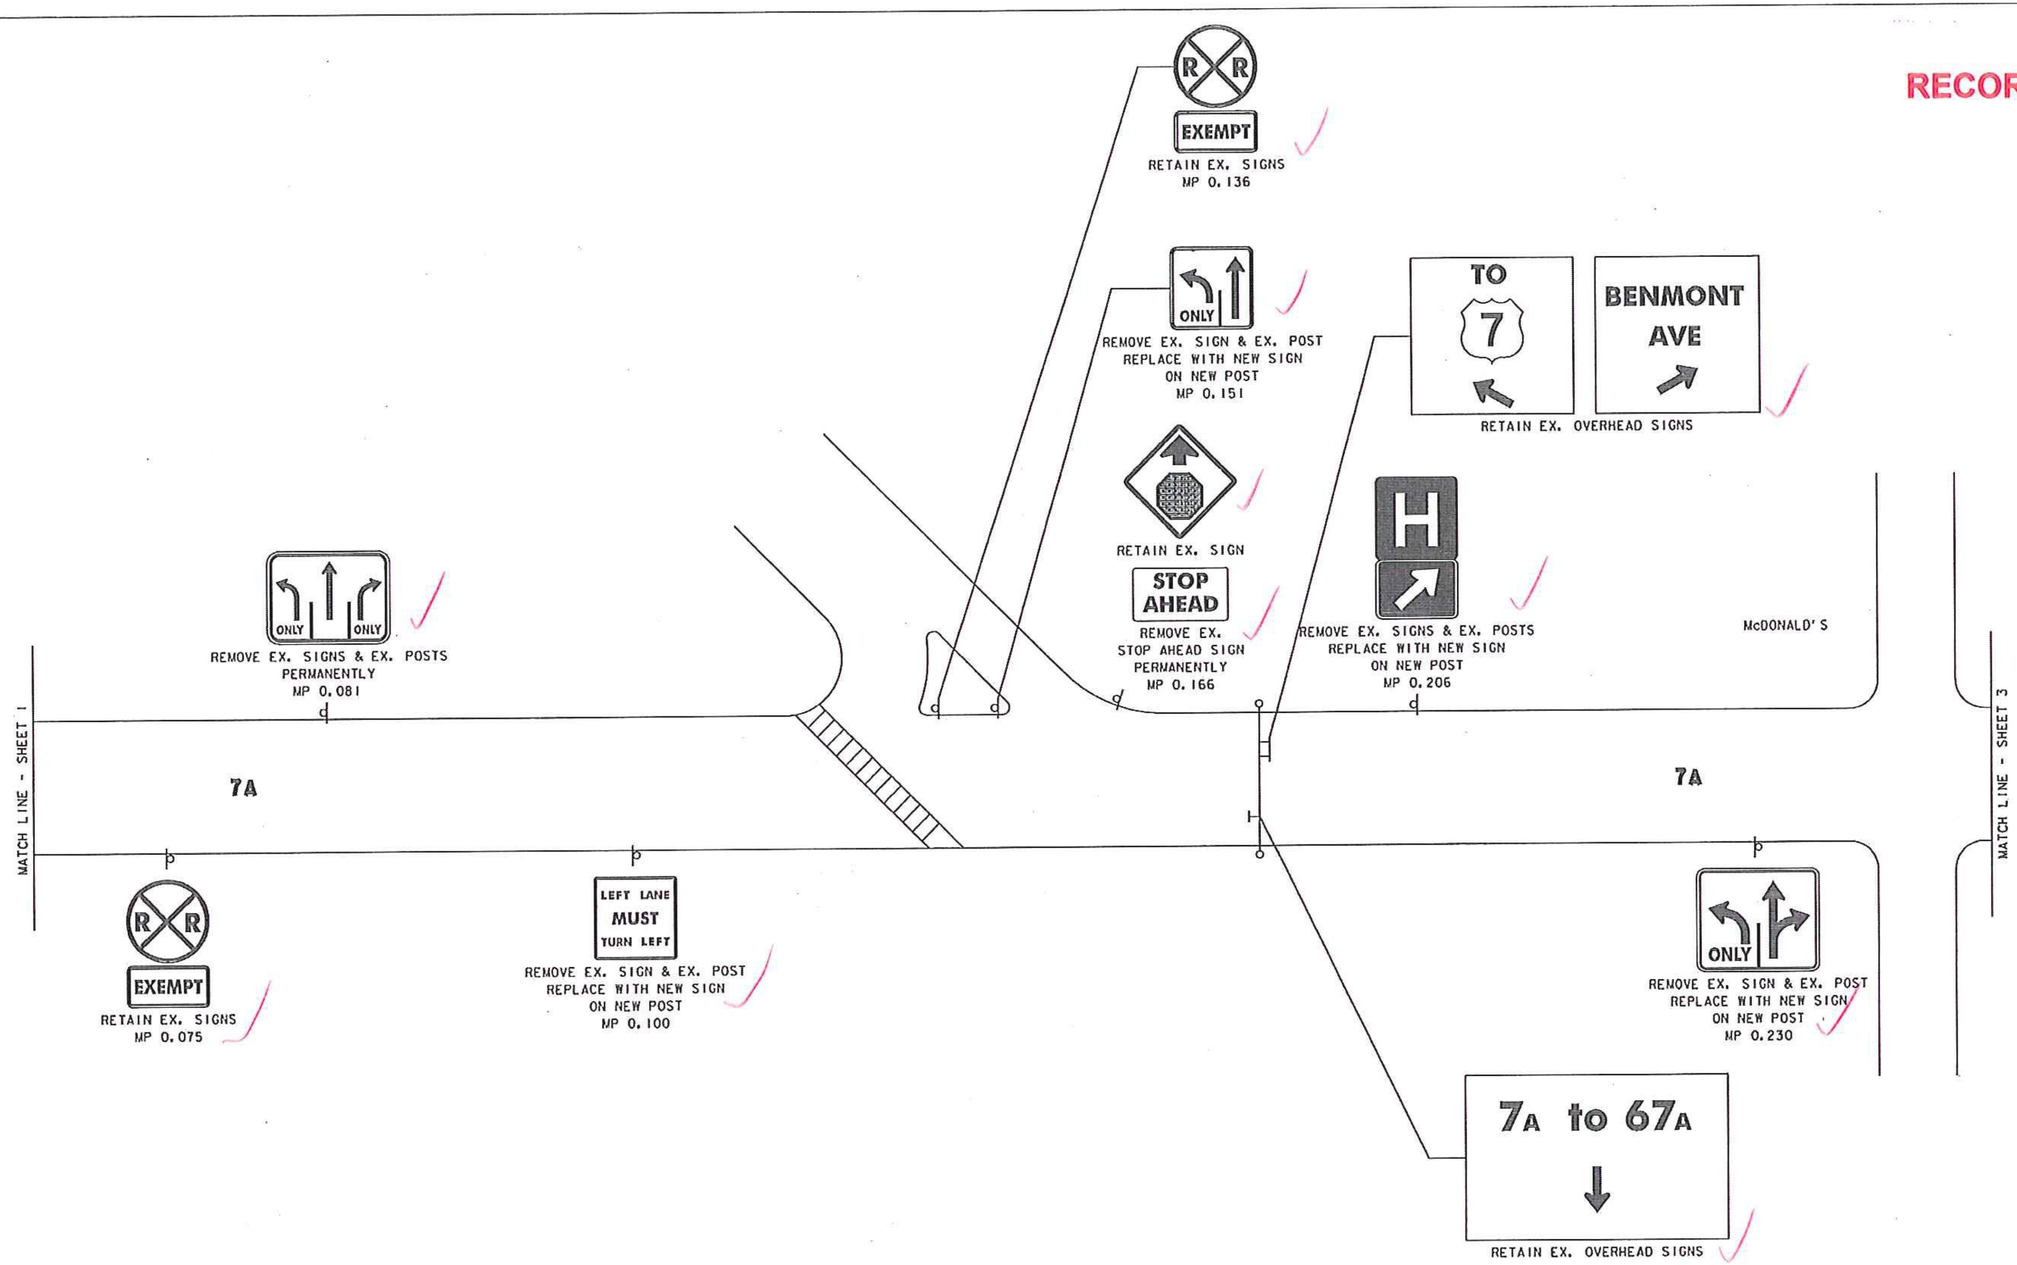


Bennington AC NH 019-1 (54)
Sign Sheets
Bennngton 7A
March 21, 2012
Not to Scale
Sheet 2 of 4

*ALL MPs ARE REFERENCED TO THE ROUTE THE SIGN SERVES

E:\2007\2007038.00 Bennington Bypass\Bennington Bypass\Contract 54\Signs\Sign Summary 03-21-12.dgn