RECORD PLANS

DIRECTION	MILEPOINT	LOCATION CODE (SHEET 2)	SIGN CODE	WIDTH (MM)	HEIGHT (MM)	SHEETING REMARKS	SIGN LEGEND	NEW SIGNS "A"	NEW SIGNS "B"	EXISTING SIGNS RETAIN	EXISTING SIGNS SALVAGE FROM	EXISTING SIGNS SALVAGE TO	EXISTING SIGNS REMOVE	EXIST POST RETAIN	EXIST POST REMOVE	NUMBER OF NEW POSTS	SQUARE STEEL (MM) 44 (KG /M) 2.8	SQUARE STEEL (MM) 50 (KG /M) 3.2	SQUARE STEEL (MM) 63 (KG /M) 5.0	TUBULAR STEEL Ø (mm) FOUNDATION	TUBULAR STEEL Ø (mm) 75 (KG /M) 11.30	TUBULAR STEEL Ø (mm) 89 (KG /M) 13.40	TUBULAR STEEL Ø (mm) 100 (KG /M) 16.10	TUBULAR STEEL Ø (mm) 125 (KG /M) 21.70	SIGN FRAME REQUIRED	REMARKS	SIGN DETAIL LOCATION SHSM	SIGN DETAIL LOCATION PROJECT SHEET #	SIGN DETAIL LOCATION STANDARD SHEET #
BENNINGTON 7A							FY-FLUORESCENT YELLOW FYG-FLUORESCENT YELLOW GREEN																		"SHSM"-STANDARD HIGHWAY SIGNS AND MARKINGS			
SB	0.305	F	VR-922L	900	750		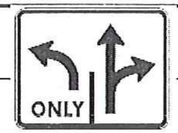 9-25-12	0.68								1	9-25-12 4.1 X												E-145A
SB	0.206	F	D9-2	600	600								1		X					Existing Removed									
		F	D9-2A	525	375								1							2 ea 9-25-12									
		F	D9-2	600	600		9-25-12	0.36								1	9-25-12 4.3 X										X		
		F	M6-2	525	375			0.20																	WHITE ON BLUE	X		
SB	0.166	F	W3-1	750	750		STOP AHEAD Retained			1				X															
		F	W3-1P	600	450		STOP AHEAD PLAQUE Removed						1							Existing Panel Removed 1 ea 9-25-12									
SB	0.151	F	VR-921L	750	750		New 9-26-12 Orig						1		X					Existing Removed 1 ea 9-26-12									
		F	VR-921L	750	750			0.56								1	9-26-12 4.0 X												E-145A
SB	0.081	F	VR-932	1200	750		LEFT "ONLY"/THRU/RIGHT "ONLY"						1		X					Existing Removed 1 ea 9-26-12									
SB	0.051	F	R3-7R	750	750		RT LANE MUST TURN RT RIGHT LANE MUST TURN RIGHT						1		X					Existing Removed 1 ea 9-26-12									
		F	VR-932	1200	750			0.90 9-26-12								2	9-26-12 8.4 X												E-145A
SB	0.03	F	M3-1	600	300								1		X														
		F	M1-4	600	600		See Next Sheet for Removal																						
		F	M6-1	525	375								1																
SIGN SUMMARY SHEET							SHEET TOTALS	2.69 SM	0.00 SM	1 EA	0 EA	0 EA	9 EA	0 EA	5 EA	5 EA	23.0 M		0 EA	0.0 KG	0.0 KG	0.0 KG	0.0 KG						
VERMONT AGENCY OF TRANSPORTATION							TOWN DIRECTIONAL TOTALS	17.85	0.0	1	0	0	46	0	26	25	115.0		0		0.0								

PROJECT NAME: Bennington
PROJECT NUMBER: NH 019-1(54)
FILE NAME: Bennington VT7A.xls
PROJECT MANAGER: 0
DESIGNED BY: T. Guazzoni
BENNINGTON VT7A SHEET 5
PLOT DATE: 3/7/2012
DRAWN BY: T. Guazzoni
CHECKED: 0
SHEET 5 OF 7