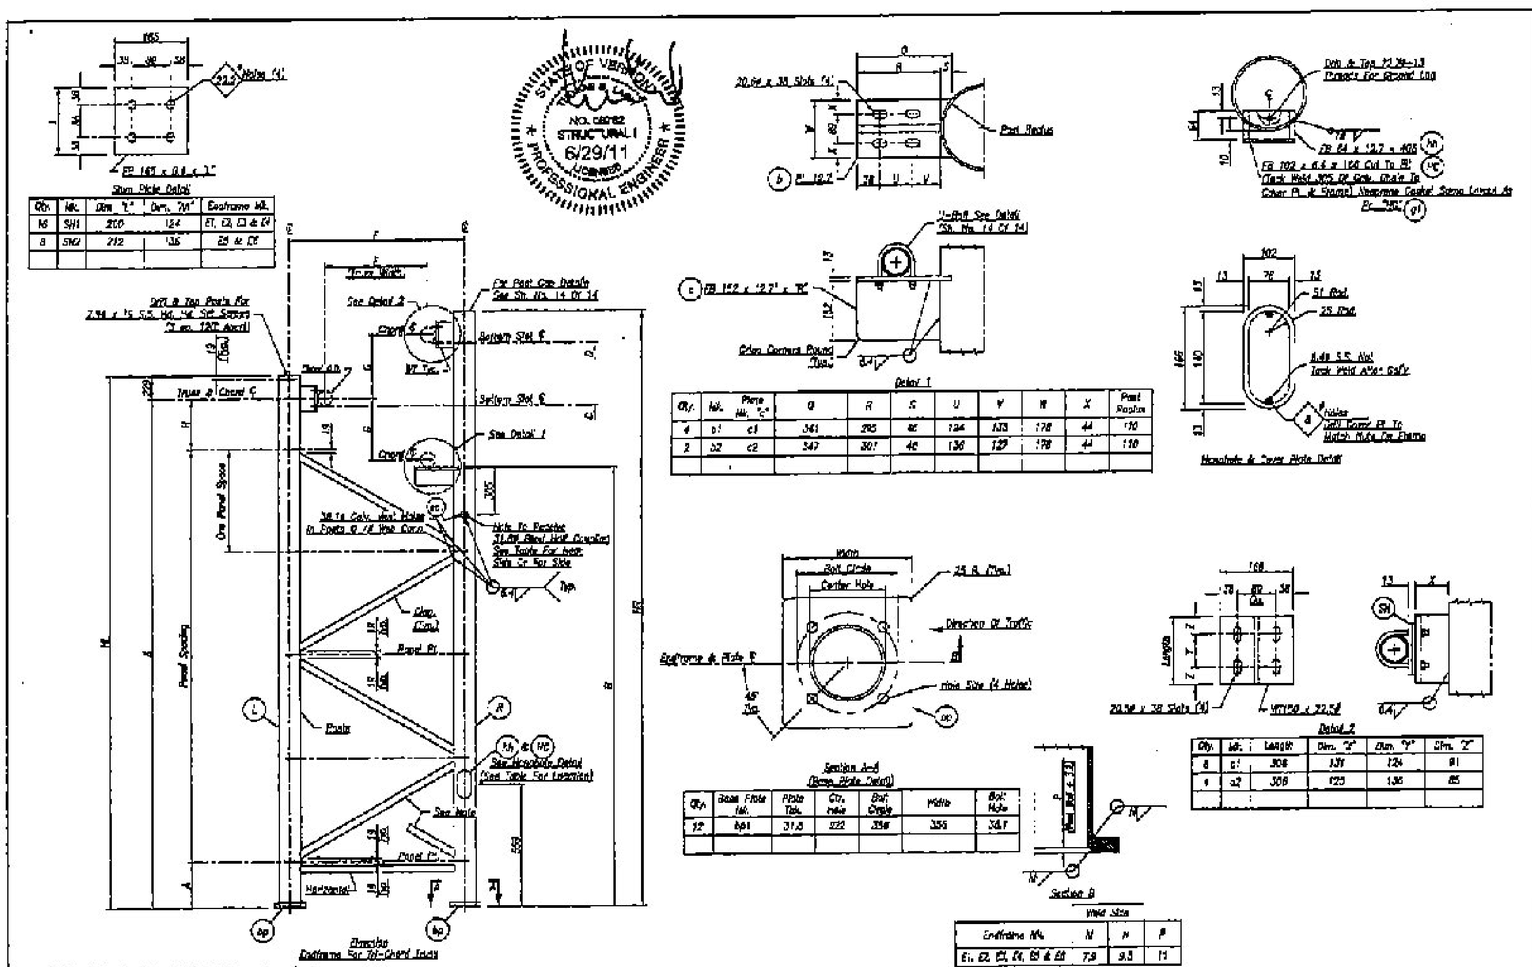
Slim Plate Detail
Detail 1
Detail 2
Section A-A
Section B
Elevation
Endframe For Tri-Chord Truss
Truss B
Truss A
Chord C
Panel Spacing
One Panel Space
Panels
Horizontal
Panel Pt.
Diag.
Direction Of Traffic
Nine Side (4 Holes)
Bolt Circle
Center Hole
Bolt Hole
See Detail 1
See Detail 2
See Table For Number Of Panels
See Table For Hole Size Or Not Side
Note To Receive 31.8ø Steel Hold Down Bar
Bottom Slot
Top Slot
Pin Post Size Detail See Sh. No. 14 Of 14
