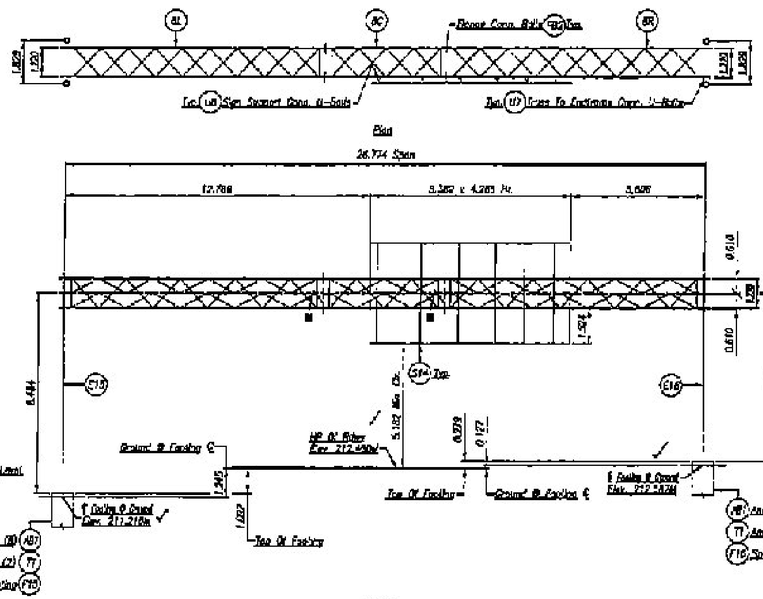

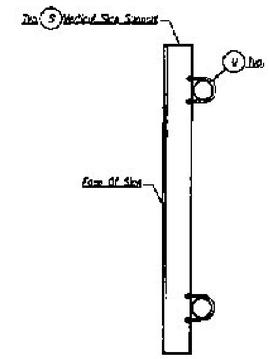

NOTES: All Dimensions Are In Inches Unless Otherwise Noted.

■ Truss Splice Mk. No's Are Stamped On The Top Of The Bottom Boom Flanges.

Contractor Has Verified Details.

Wind Design Speed: 144.8 KMPH
Sign Loading: 1.4 KN/m²

PRINTS ISSUED						REVISIONS		
FOR	NO.	DATE	FOR	NO.	DATE	NO.	DATE	DESCRIPTION
						1	12-21-11	Up To Match Cont. 10.1

Brookfield Fabricating Corp

P.O. Box 106– Brookfield, Missouri 64628– (660)258-2214

F.R. Lafayette Inc.

IM 016-1(24)
Bennington County, Vermont

Erection Details Of Bi-Chord Truss @ Sta. WB 104.155.8

Sheet No. 1 of 2

Previous Use	Drawn By	Date	Checked By	Date	Job No.	Rev
Vermont	AE	12-20-10	CDF AW	12-20-10	W-11862	

STATE OF VERMONT
NO. 05786
STRUCTURAL
6/29/11
LICENSED
PROFESSIONAL ENGINEER

Y:\states\VT\11000-11999\11862\11862 Part C\1B6201C.dwg

RECEIVED
FEB 7 2012
G.P.I.