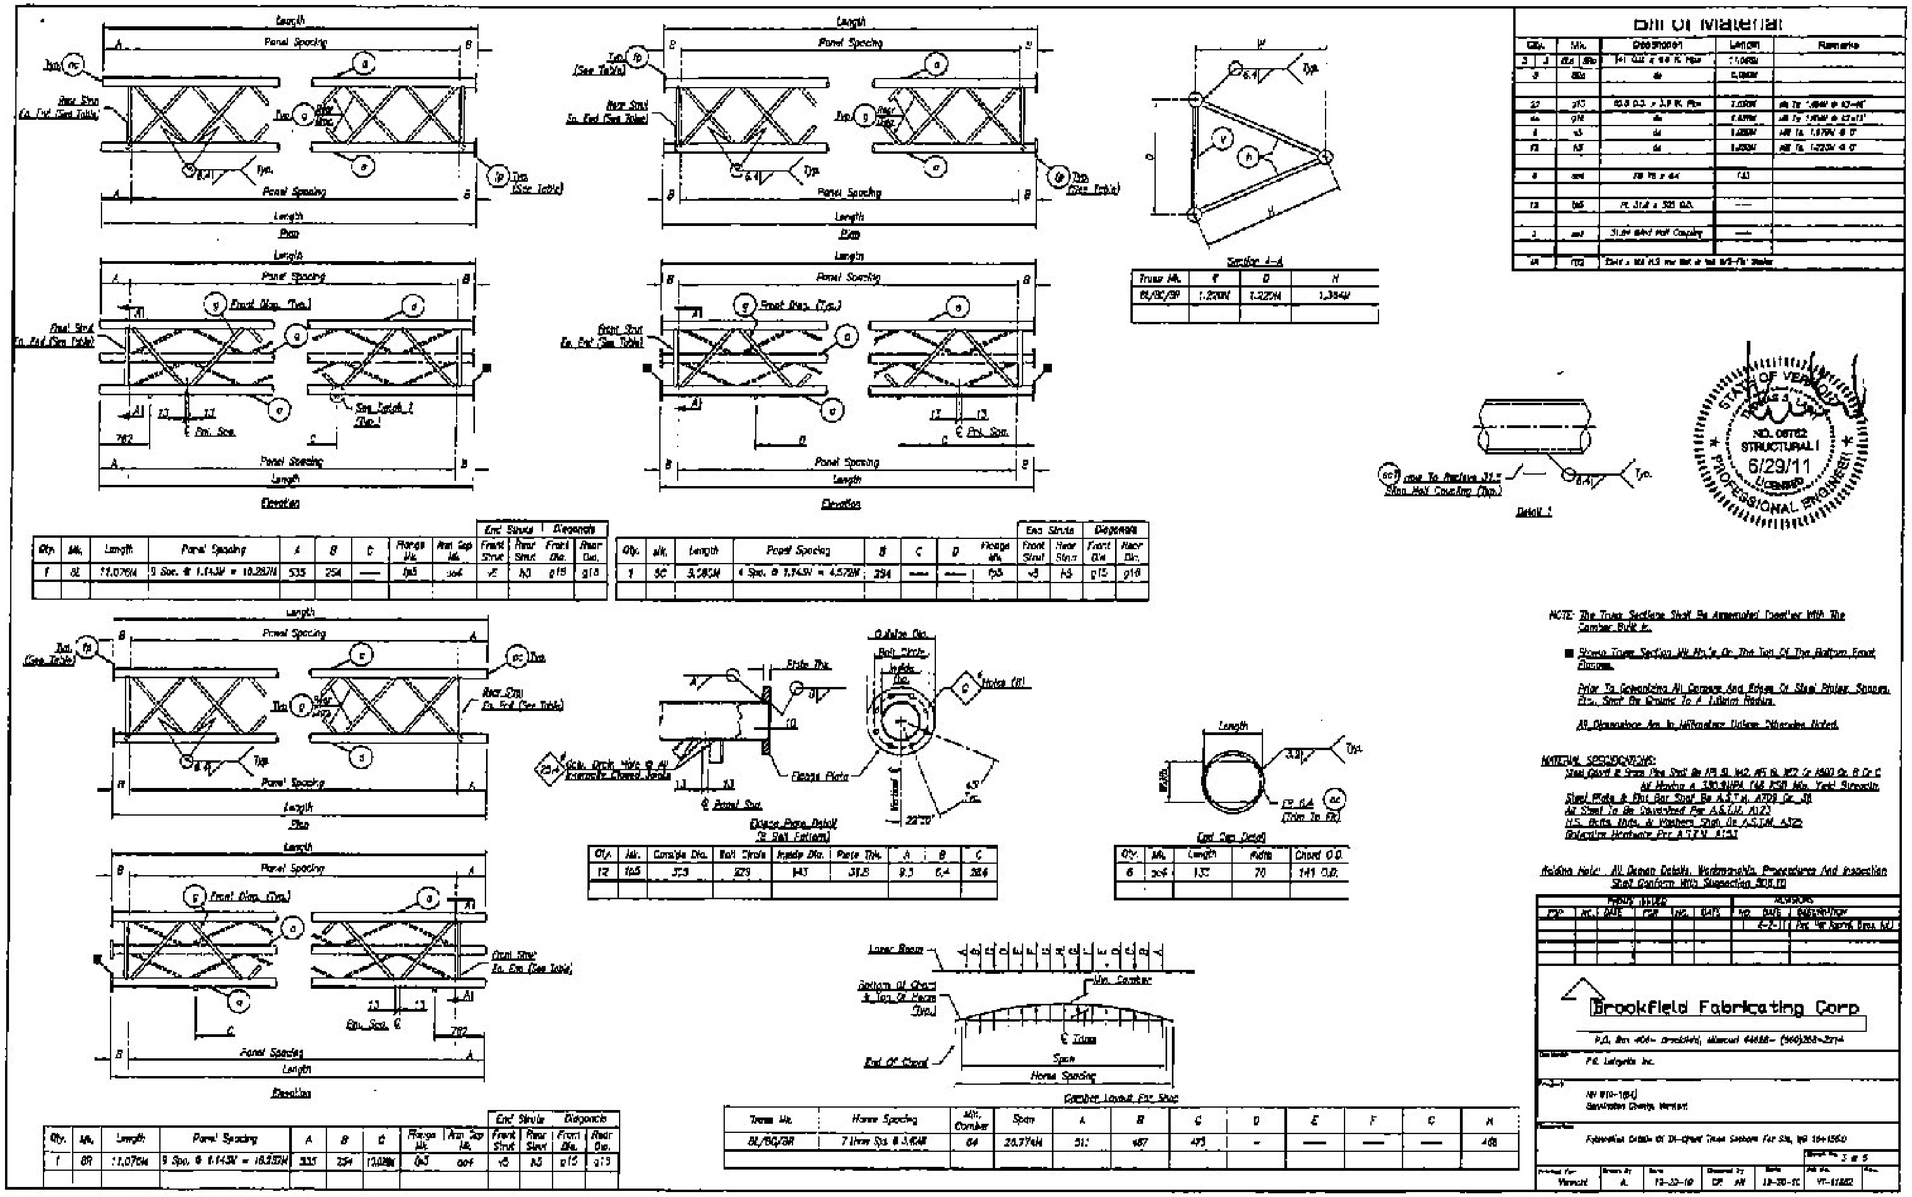

RECEIVED

FEB 7 2012

GPI