INDEX OF SHEETS
SEE SHEET 2

RECORD PLANS	
CONTRACTOR:	KUBRICKY CONSTRUCTION CORP.- GLENS FALLS, NY
RESIDENT ENGINEER:	SANDRA HUNT
CONSTRUCTION BEGAN:	JULY 12, 2010
CONSTRUCTION COMPLETE:	NOVEMBER 19, 2010
RECORD PLANS BY:	SANDRA HUNT & AMOS KEMPTON

I HEREBY CERTIFY THAT ALL THE CONSTUCTION REQUIRED BY THIS SET OF DRAWINGS HAS BEEN ACCOMPLISHED AS INDICATED HEREIN.

BY Sandra E. Hunt RESIDENT ENGINEER

DATE 5/7/12

NOTE: Any further information concerning final quantities, amounts or other details relative to this project may be found at Central Files in the electronic archives.

STATE OF VERMONT
AGENCY OF TRANSPORTATION

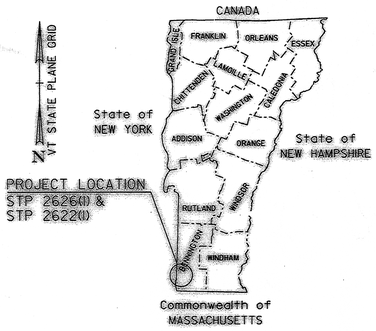

PROPOSED IMPROVEMENT
TOWN OF BENNINGTON AND VILLAGE OF NORTH BENNINGTON
COUNTY OF BENNINGTON
VT. ROUTE 67A & 67

BENNINGTON
STP 2626(I)
SEE SHEET 9
FOR ADDITIONAL PROJECT INFORMATION
AND THE SUPERPAVE DESIGN CRITERIA

BENNINGTON (NORTH BENNINGTON) CLASS I
STP 2622(I)
SEE SHEET 50
FOR ADDITIONAL PROJECT INFORMATION
AND THE SUPERPAVE DESIGN CRITERIA

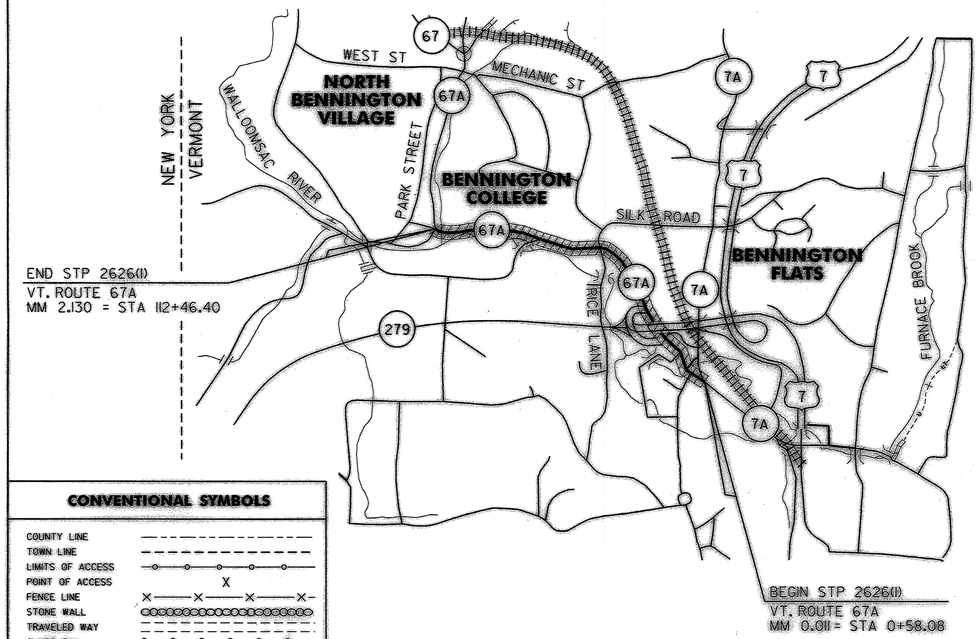

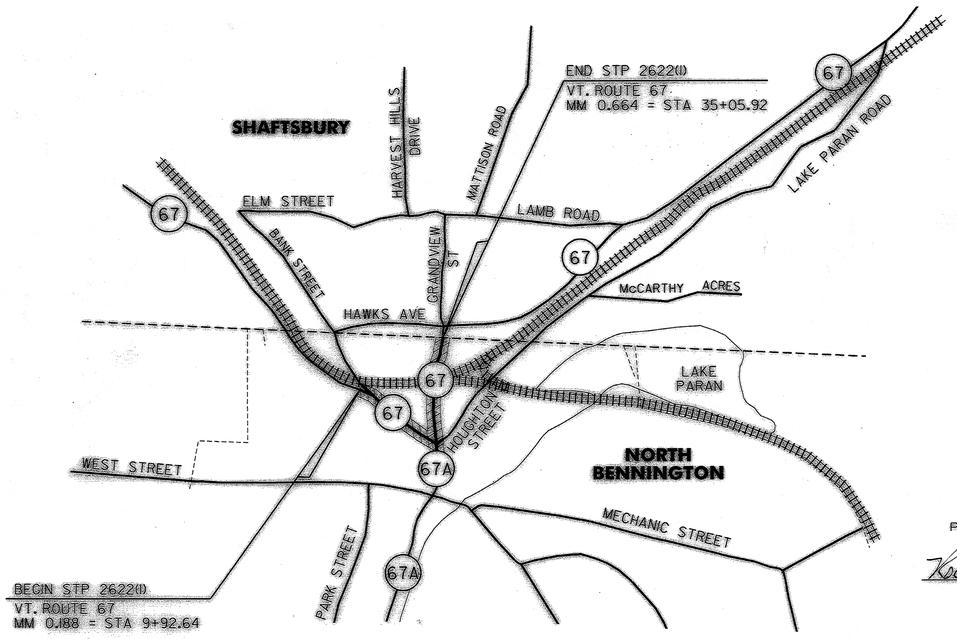

CONVENTIONAL SYMBOLS

COUNTY LINE	
TOWN LINE	
LIMITS OF ACCESS	
POINT OF ACCESS	X
FENCE LINE	
STONE WALL	
TRAVELED WAY	
GUARD RAIL	
RAILROAD	
SURVEY LINE	
CULVERT	
POWER POLE	
TELEPHONE POLE	
TREES	
CONTROL OF ACCESS	
PROPERTY LINE	
R.O.W. TAKING LINE	
SLOPE RIGHTS	SR SR SR
TOP OF CUT	
TOE OF SLOPE	

SURVEYED BY : NA
SURVEYED DATE : NA

DATUM
VERTICAL NA
HORIZONTAL NA

THESE PLANS ARE SUBJECT TO SUCH ENGINEERING CHANGES AS MAY BE REQUIRED BY THE FEDERAL HIGHWAY ADMINISTRATION OR THE DIRECTOR OF PROGRAM DEVELOPMENT.

CONSTRUCTION IS TO BE CARRIED ON IN ACCORDANCE WITH THESE PLANS AND THE STANDARD SPECIFICATIONS FOR CONSTRUCTION DATED 2006, AS APPROVED BY THE FEDERAL HIGHWAY ADMINISTRATION ON JUNE 15, 2006 FOR USE ON THIS PROJECT, INCLUDING ALL SUBSEQUENT REVISIONS AND SUCH REVISED SPECIFICATIONS AND SPECIAL PROVISIONS AS ARE INCORPORATED IN THESE PLANS.

STATE OF VERMONT
ROBERT A. GRAHAM
No. 6581
REGISTERED
PROFESSIONAL ENGINEER

PLANS PREPARED BY

Robert A. Graham

CHA

DIRECTOR OF PROGRAM DEVELOPMENT
APPROVED Richard Fillman DATE 3-11-10

PROJECT MANAGER : MIKE FOWLER

PROJECT NAME : BENNINGTON & BENNINGTON (NORTH BENNINGTON) CLASS I

PROJECT NUMBER : STP 2626(I) & STP 2622(I)

SHEET 1 OF 69 SHEETS