INDEX OF SHEETS
SEE SHEET 2

STATE OF VERMONT
AGENCY OF TRANSPORTATION

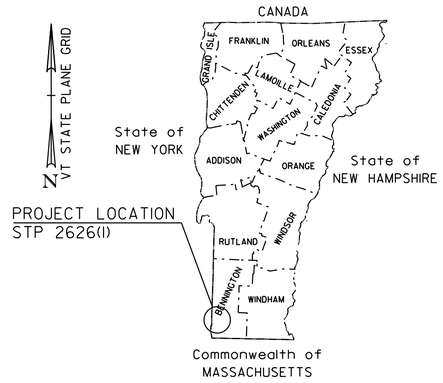

PROPOSED IMPROVEMENT
TOWN OF BENNINGTON
COUNTY OF BENNINGTON
VT. ROUTE 67A

BEGINNING IN THE TOWN OF BENNINGTON ON VT. ROUTE 67A AT MILE MARKER 0.011 = STA 0+58.08 AND EXTENDING NORTHERLY FOR A DISTANCE OF 11,188.32 FEET (2.119 MILES) TO A POINT IN THE TOWN OF BENNINGTON AT MILE MARKER 2.130 = STA 112+46.40.

LENGTH OF ROADWAY 11,188.32 FT (2.119 MILES)
LENGTH OF PROJECT 11,188.32 FT (2.119 MILES)

WORK TO BE PERFORMED UNDER THIS PROJECT INCLUDES COLD PLANING AND RESURFACING OF THE EXISTING HIGHWAY WITH A SHIM/LEVELING COURSE AND WEARING COURSE, NEW PAVEMENT MARKINGS, GUARDRAIL IMPROVEMENTS, DRAINAGE IMPROVEMENTS AND INCIDENTAL ITEMS.

LONG LINES WERE CHANGED FROM THERMOPLASTIC TO PAINT BY CHANGE ORDER. HANDWORK REMAINS THERMOPLASTIC. THIS CHANGE APPLIES TO STP 2626(I) ONLY.

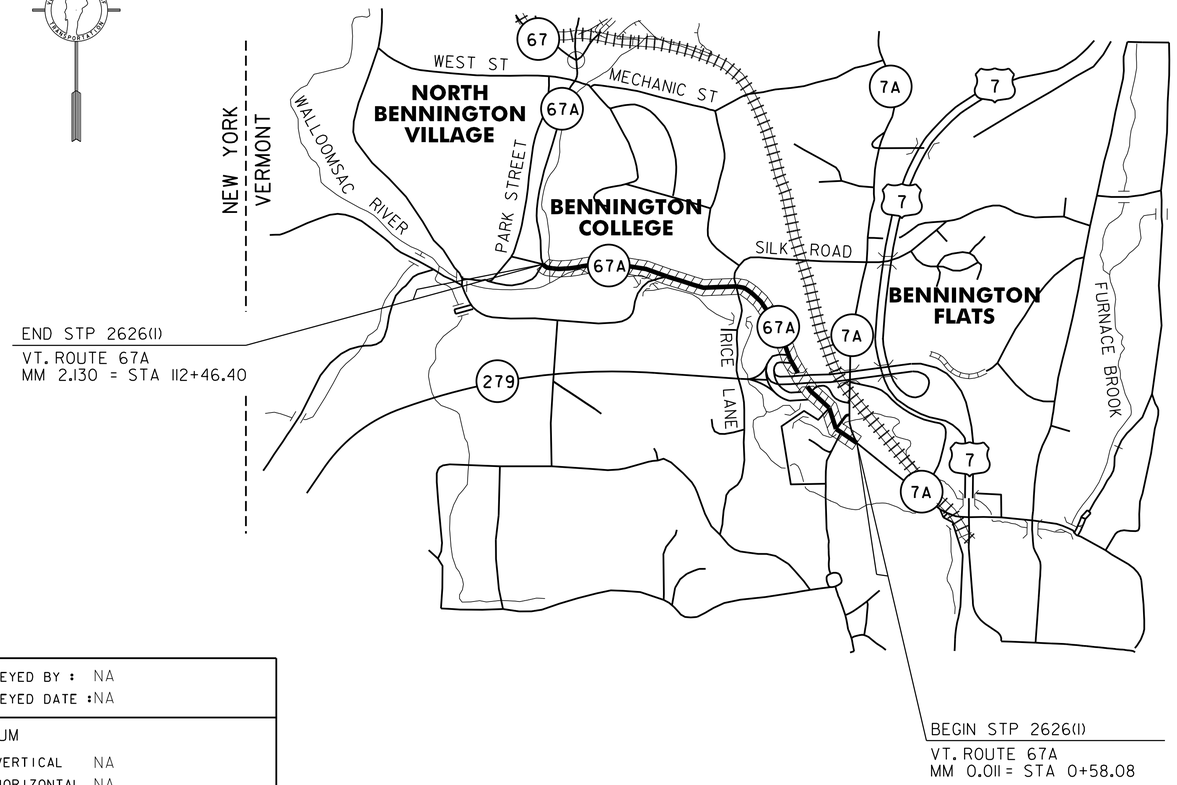

BITUMINOUS CONCRETE SUPERPAVE MIXTURE DESIGN CRITERIA	
DESIGN LANE/DESIGN LIFE ESAL	1,382,500
DESIGN NUMBER OF GYRATIONS	65
PERFORMANCE GRADE ASPHALT BINDER	SEE SECTION 490 GENERAL SPECIAL PROVISIONS

TRAFFIC DATA

SECTIONS	ADT		DHV		ESALS	ESALS
	2010	2020	2010	2020	2010-2020	2010-2030
BEGIN PROJECT TO VT. 279 RAMPS C&D	10,600	10,800	1100	1100	1,217,000	2,746,000
VT. 279 RAMPS C&D TO VT. 279 RAMPS A&B	11,100	11,400	1200	1200	1,191,000	2,765,000
VT. 279 RAMPS A&B TO RICE LANE/SILK ROAD	8000	8200	830	850	748,000	1,731,000
RICE LANE/SILK ROAD TO END PROJECT	7300	7500	760	780	584,000	1,344,000

CONVENTIONAL SYMBOLS

COUNTY LINE
TOWN LINE
LIMITS OF ACCESS
POINT OF ACCESS
FENCE LINE
STONE WALL
TRAVELED WAY
GUARD RAIL
RAILROAD
SURVEY LINE
CULVERT
POWER POLE
TELEPHONE POLE
TREES
CONTROL OF ACCESS
PROPERTY LINE
R.O.W. TAKING LINE
SLOPE RIGHTS
TOP OF CUT
TOE OF SLOPE

SURVEYED BY : NA
SURVEYED DATE : NA

DATUM
VERTICAL NA
HORIZONTAL NA

THESE PLANS ARE SUBJECT TO SUCH ENGINEERING CHANGES AS MAY BE REQUIRED BY THE FEDERAL HIGHWAY ADMINISTRATION OR THE DIRECTOR OF PROGRAM DEVELOPMENT.

CONSTRUCTION IS TO BE CARRIED ON IN ACCORDANCE WITH THESE PLANS AND THE STANDARD SPECIFICATIONS FOR CONSTRUCTION DATED 2006, AS APPROVED BY THE FEDERAL HIGHWAY ADMINISTRATION ON JUNE 15, 2006 FOR USE ON THIS PROJECT, INCLUDING ALL SUBSEQUENT REVISIONS AND SUCH REVISED SPECIFICATIONS AND SPECIAL PROVISIONS AS ARE INCORPORATED IN THESE PLANS.

PROJECT MANAGER : MIKE FOWLER

PROJECT NAME : BENNINGTON
PROJECT NUMBER : STP 2626(I)

SHEET 9 OF 69 SHEETS