TEMPORARY 4" WHITE LINE, PAINT
DURABLE 4" WHITE LINE, THERMOPLASTIC
120+00 TO 125+73 SOLID LT
120+00 TO 130+50 SOLID RT
126+53 TO 130+50 SOLID LT

TEMPORARY 4" YELLOW LINE, PAINT
DURABLE 4" YELLOW LINE, THERMOPLASTIC
120+00 TO 125+93 SOLID LT & RT
126+33 TO 130+50 SOLID LT & RT

REMOVAL AND DISPOSAL OF GUARDRAIL
123+82.0 TO 125+94.0 LT
124+03.0 TO 126+24.0 RT
129+28.0 TO 130+50.0 LT
129+48.0 TO 130+50.0 RT

STEEL BEAM GUARDRAIL, GALVANIZED
124+19.0 TO 125+56.5 LT
124+40.5 TO 125+90.5 RT
129+65.5 TO 130+50.0 LT
129+83.0 TO 130+50.0 RT

MANUFACTURED TERMINAL SECTION, FLARED
DELINEATOR WITH STEEL POST
123+81.5 LT
124+03.0 RT
125+94.0 LT
126+28.0 RT
129+28.0 LT
129+45.5 RT

REMOVING SIGNS
AS SHOWN - 8

ERECTING SALVAGED SIGNS
AS SHOWN - 3

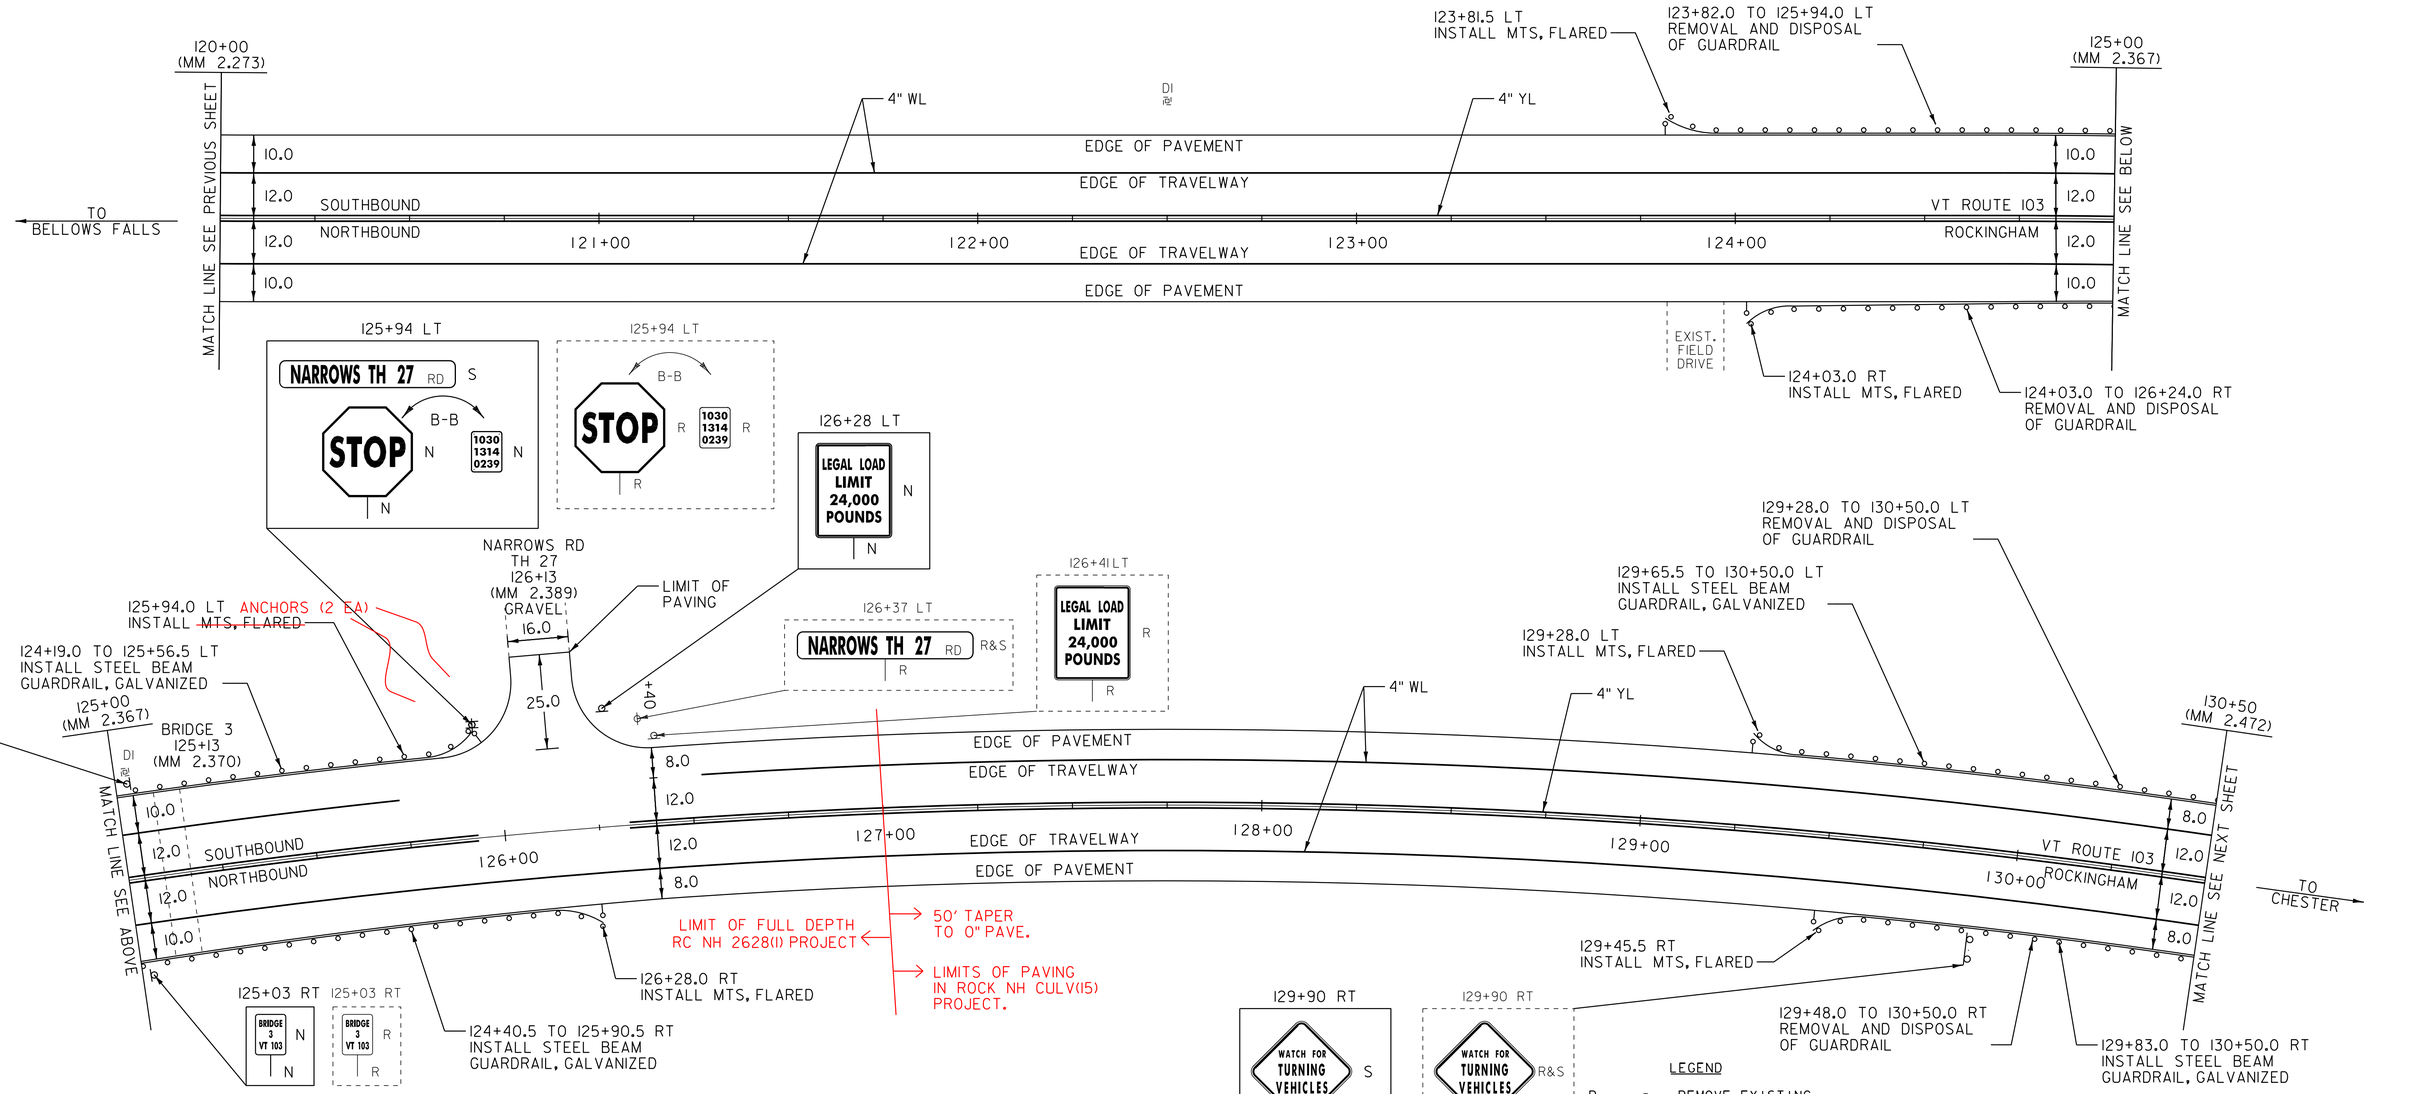

NOT TO SCALE

LEGEND

R	=	REMOVE EXISTING
S	=	SALVAGE
R&S	=	REMOVE AND SALVAGE
N	=	NEW
RET	=	RETAIN
B-B	=	BACK TO BACK
	=	EXISTING GUARDRAIL
	=	PROPOSED GUARDRAIL
YL	=	YELLOW LINE
WL	=	WHITE LINE
	=	TYPE I DELINEATOR, WHITE

PAVING LAYOUT 16

PROJECT NAME: ROCKINGHAM-CHESTER
PROJECT NUMBER: NH 2628(I)

FILE NAME: 06B224
PROJECT LEADER: PTS
DESIGNED BY: NLL
IPARM FILE NAME: pb224lal6.i
PLOT DATE: 31-AUG-2012 14:02
DRAWN BY: MRS
CHECKED BY: PTS
SHEET 30 OF 82