STATE OF VERMONT
AGENCY OF TRANSPORTATION

TRAFFIC SIGN SUMMARY SHEET

MILEMARKER, STATION, OR SIGN NUMBER	SIGN LEGEND	SIGN DIMENSIONS EA	WIDTH (In)	HEIGHT (In)	NEW & SALVAGED SIGNS "A"	"B"	SALV SIGN	SALV TIS	EXIST POST RETAIN	SALVAGE	NEW SIGN POSTS NO. OF POSTS	FLANGED CHANNEL lb/ft 1.12	2.0	3.0	SQUARE STEEL (In) lb/ft 1.75 1.88	2.0 2.16	2.5 3.35	ANCHOR	SLEEVE	TUBULAR ALUMINUM Ø (In) lb/ft 3.0 1.3	4.0 1.7	4.0 MOD 1.7	TUBULAR STEEL Ø (In) lb/ft FOUND-ATION	3.0 7.6	3.5 9.0	4.0 10.8	5.0 14.6	W-SHAPE STEEL FTG. SIZE 24'	30'	WEIGHT	POST SIZE	SIGN REQUIRED	REMARKS	SIGN DETAIL DETAIL ON SHEET NUMBER	STD. SHEET NUMBER
												OPTION ITEMS																							
8+50.0, LT 3.27 RT MM		2 2	36 34	36 18	18.00 8.50		~~1~~ ~~1~~				2					'X'		1																W2-2 (L) W16-8		
9+50.0, RT		1	30	30	6.25						1					'X'		1																VR-921 (L)		E-145A
11+19.0, LT							1 1				1					'X'		1																M3-3 M1-4 (7)		
12+36.0, RT		1	30	30	6.25						1					'X'		1																R3-7L		E-140
17+63.19, LT							1 1				2					'X'		1																W2-2 (R) W16-8		
50+48.0, LT	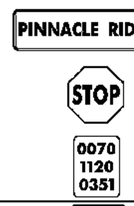	1 1	41.5 30	~~9~~ ~~6~~ 30	~~2.58~~ ~~1.73~~ 6.25		~~1~~ 1				1					'X'		1																D3 R1-1 REF PLAQUE		E-123
51+03.8, RT							1				1					'X'		1																VR-079		
FINAL POST LENGTHS ARE TO BE DETERMINED IN THE FIELD. POST SIZES ARE COMPUTED BASED ON INFORMATION FURNISHED ON THE STANDARD SHEETS AND THE VTRANS "SIGN POST DESIGN GUIDELINE."												FT	FT	FT	FT	FT 171	FT		EA 7	LB	LB	LB		LB	LB	LB	LB							
		TOTALS			SF ~~14.23~~ 47.83	SF	EA. 9	SF				FT			FT 171					LB			EA.	LB				EA.	EA.	LB				

PROJECT NAME: RUTLAND TOWN
PROJECT NUMBER: HES INTS(4)

FILE NAME: z05kll4ss.dgn
PROJECT LEADER: DWB
DESIGNED BY: DWB
SIGN SUMMARY SHEET

PLOT DATE: 3/3/2009
DRAWN BY: TSK
CHECKED BY: DWB
SHEET 28 OF 36