646.402 DURABLE 4 INCH WHITE LINE, THERMOPLASTIC
(ALL LINES WILL INCLUDE EDGE LINE BREAKS AND RADIUS FOR TOWN HIGHWAYS)
FAIR HAVEN:
STA 68+00.00 - STA 73+00.00 LT & RT

646.602 TEMPORARY 4 INCH WHITE LINE, PAINT
(ALL LINES WILL INCLUDE EDGE LINE BREAKS AND RADIUS FOR TOWN HIGHWAYS)
FAIR HAVEN:
STA 68+00.00 - STA 73+00.00 LT & RT

646.412 DURABLE 4 INCH YELLOW LINE, THERMOPLASTIC
(ALL LINES WILL INCLUDE C/L BREAKS FOR TOWN HIGHWAYS) S=SOLID, D=DASHED

FAIR HAVEN:	LT	℄	RT
STA 68+00.00 - STA 73+00.00	S	-	S

646.612 TEMPORARY 4 INCH YELLOW LINE, PAINT
(ALL LINES WILL INCLUDE C/L BREAKS FOR TOWN HIGHWAYS) S=SOLID, D=DASHED

FAIR HAVEN:	LT	℄	RT
STA 68+00.00 - STA 73+00.00	S	-	S

646.442 DURABLE 8 INCH WHITE LINE, THERMOPLASTIC

FAIR HAVEN:
STA 69+33.00 - STA 69+45.00 FIRE HYDRANT NO PARKING ZONE, LT

675.50 REMOVING SIGNS
AS SHOWN - 1

675.60 ERECTING SALVAGED SIGNS
AS SHOWN - 2

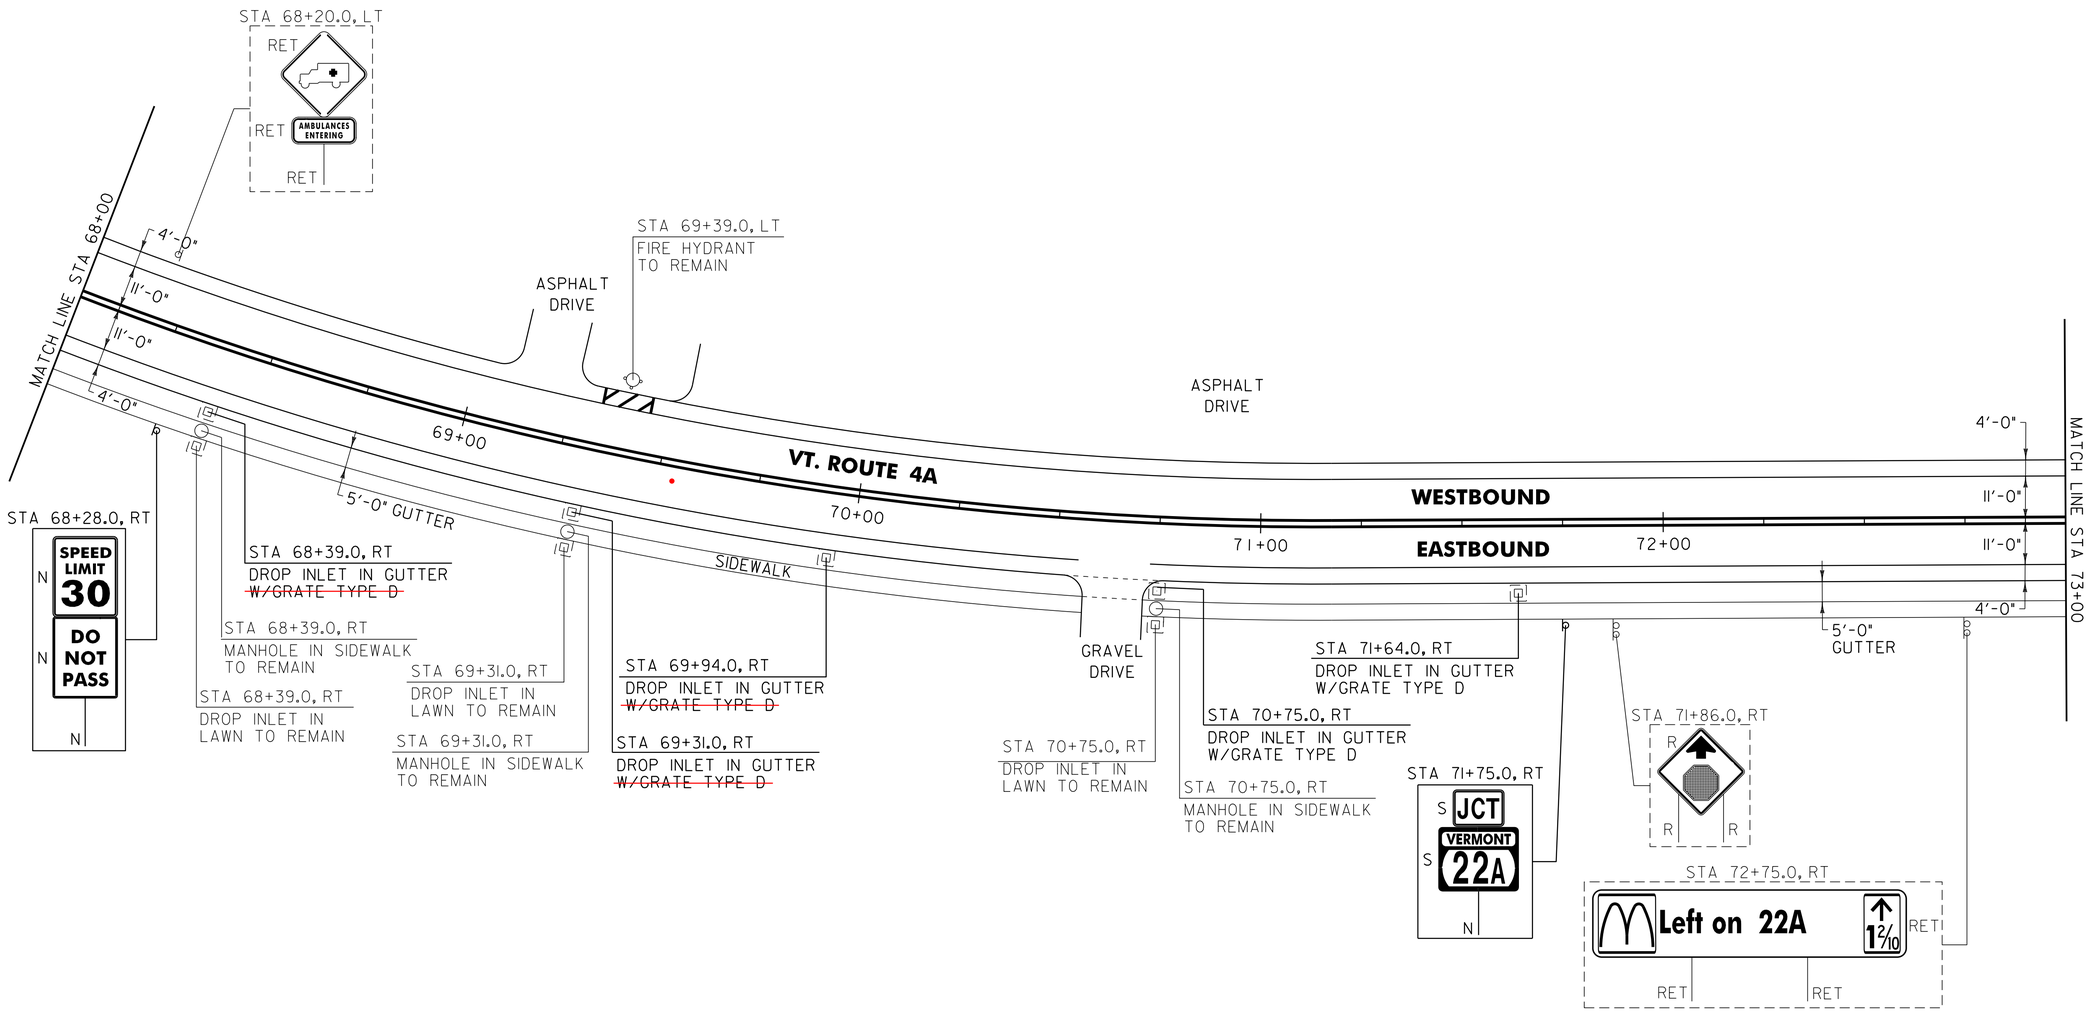

604.42 CHANGING ELEVATION OF S.M.H.
STA 69+58 RT

604.412, 604.415 OR 604.418
REHAB. DROP INLETS, CATCH BASINS OR MANHOLES (SEE NOTE 1)

FAIR HAVEN:
STA 68+39.0 RT
STA 69+31.0 RT
STA 69+94.0 RT
STA 70+75.0 RT
STA 71+64.0 RT
→ DID NOT TOUCH

616.47 BITUMINOUS CONCRETE GUTTERS AND TRAFFIC ISLANDS

FAIR HAVEN:
STA 68+00.0 - STA 73+00.0 RT (30.9 TON)

NOTES:

1. THE CONTRACTOR SHALL REHAB. THE EXISTING DROP INLETS, CATCH BASINS OR MANHOLES TO A DEPTH AS DIRECTED BY THE RESIDENT ENGINEER. ALL REHAB. WORK WILL BE PAID FOR UNDER THE APPLICABLE REHAB. ITEM AS DIRECTED BY THE RESIDENT ENGINEER. ALL EXISTING UTILITIES MARKED "TO REMAIN" SHALL NOT BE ALTERED OR REHABILITATED UNLESS DIRECTED OTHERWISE BY THE RESIDENT ENGINEER.

2. SEE SHEET 10 FOR FIRE HYDRANT MARKING DETAIL.

SIGN LEGEND
R = REMOVE
S = SALVAGE
N = NEW
RET = RETAIN
B-B = BACK TO BACK
EXISTING = - - - - - -
NEW = ————

NOT TO SCALE

PROJECT LAYOUT SHEET #5

PROJECT NAME: FAIR HAVEN
PROJECT NUMBER: STP 2615(11)S

FILE NAME: p06c060.dgn
PROJECT LEADER: D.E.G.
DESIGNED BY: M.J.M.
IPARM FILE: p06c060105.i

PLOT DATE: 22-FEB-2012 12:5
DRAWN BY: C.A.K.
CHECKED BY: D.E.G.
SHEET 92 OF 157