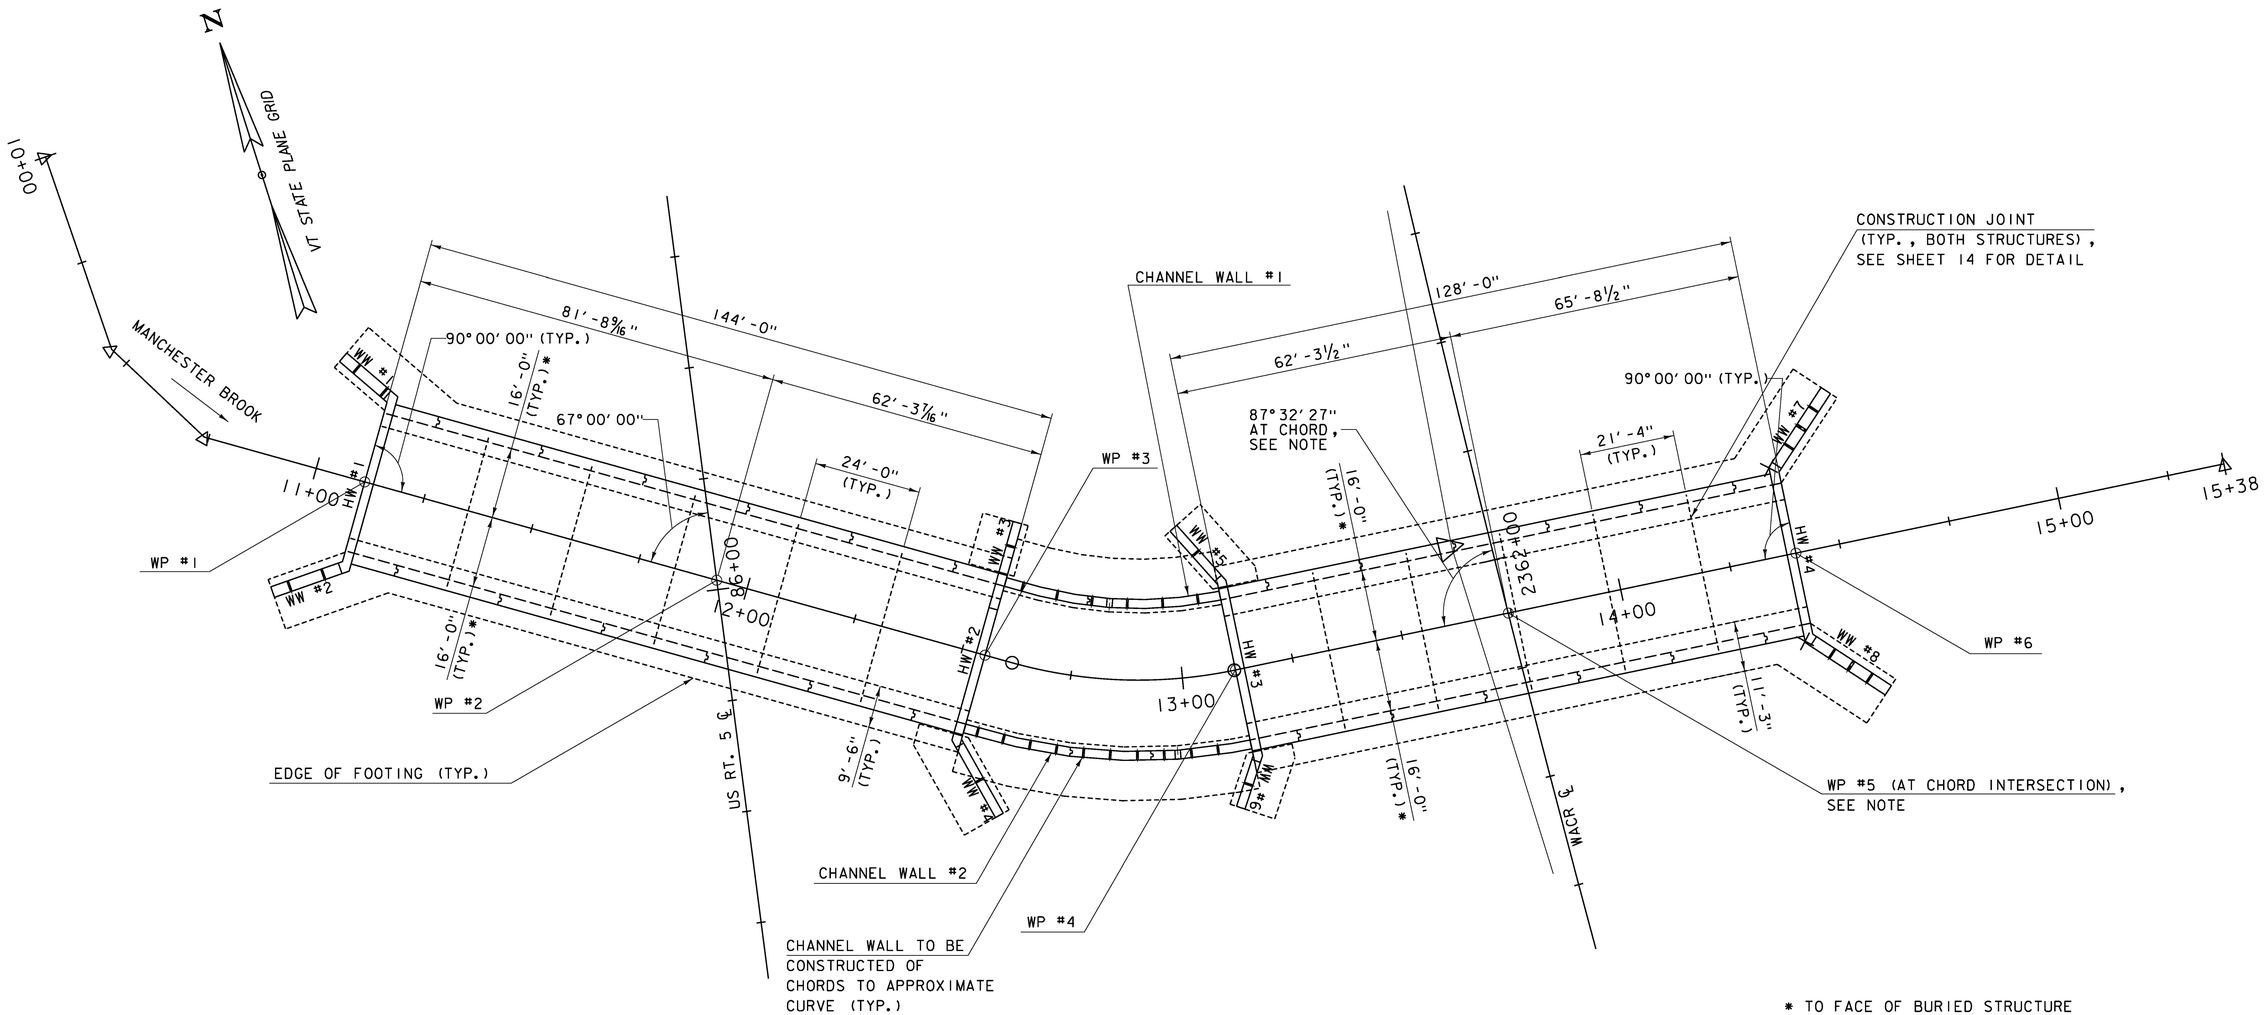

* TO FACE OF BURIED STRUCTURE

STRUCTURE LAYOUT

SCALE 1/16" = 1'-0"

WORKING POINT COORDINATES

	CHANNEL STA.	NORTHING	EASTING
WP #1	11+11.25	623633.6216	1755382.1221
WP #2	11+92.96	623588.7598	1755450.4213
WP #3	12+55.25	623554.5653	1755502.4803
WP #4	13+12.00	623534.3994	1755554.8424
WP #5	13+74.33	623527.9789	1755616.8344
WP #6	14+40.00	623521.2131	1755682.1613

NOTE: WACR CHORD IS BETWEEN BEGIN AND END CULVERT STATIONS ON WACR ℄.

PROJECT NAME: RYEGATE
PROJECT NUMBER: STP CULV(10)

ECI ENGINEERS CONSTRUCTION — DuBois & King INC.

FILE NAME: z06c156strlay.dgn
PROJECT LEADER: E. DETRICK
DESIGNED BY: R. BARNES
STRUCTURE LAYOUT

PLOT DATE: 3/23/16
DRAWN BY: R. BARNES
CHECKED BY: E. DETRICK
SHEET 11 OF 36