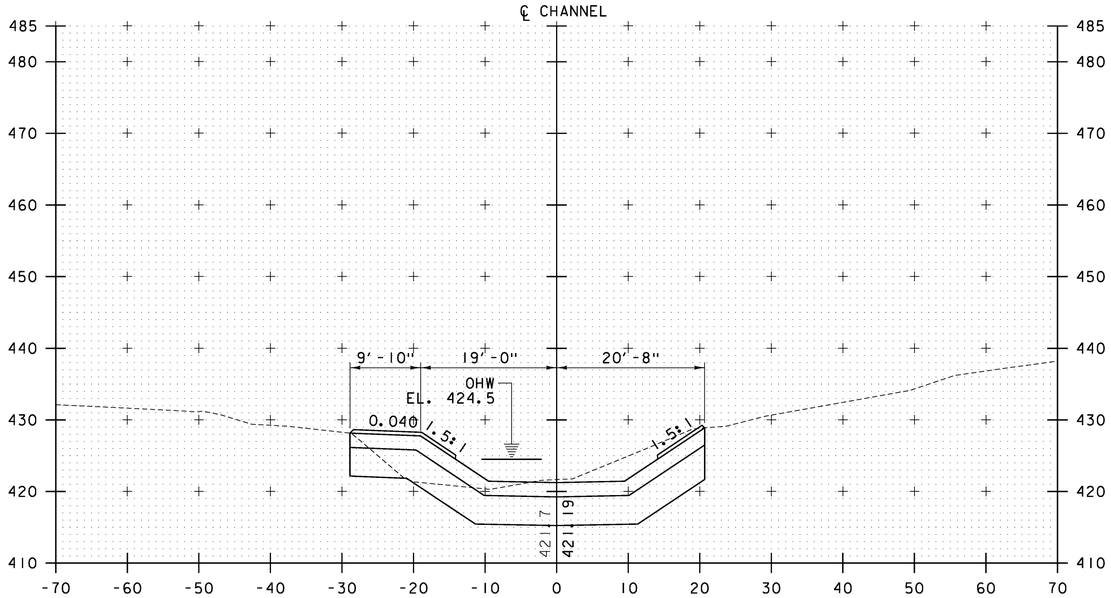

15+25

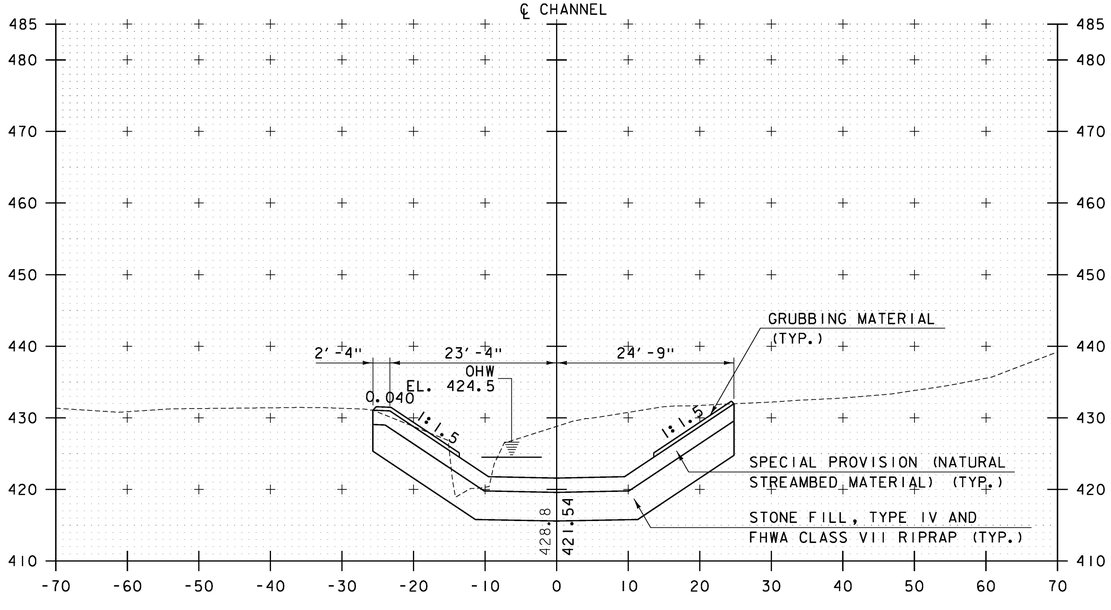

15+00

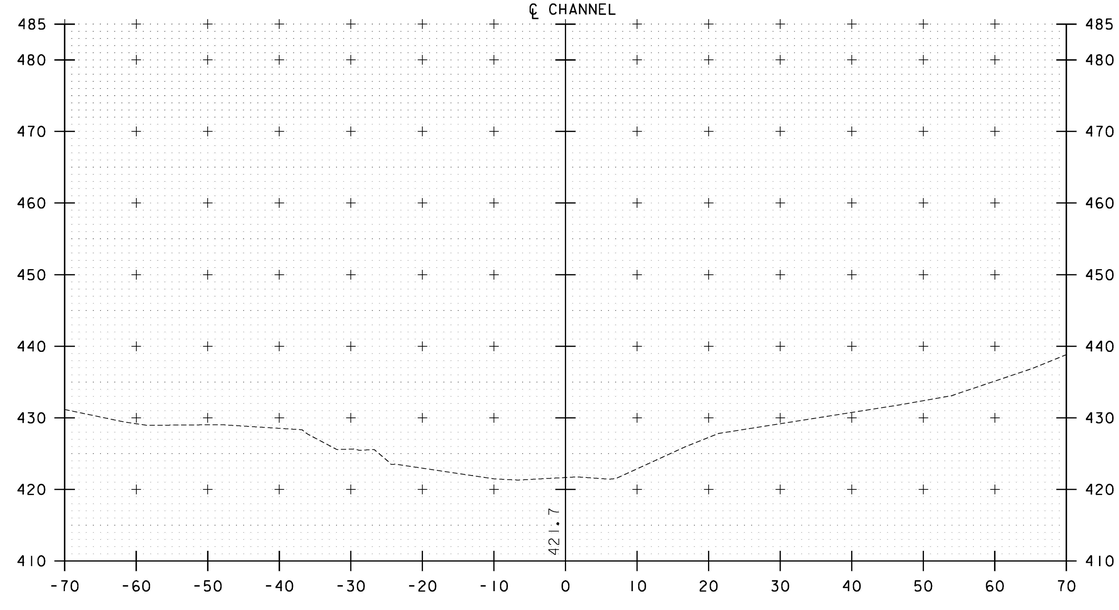

STA. 15+32.89
END STONE FILL, TYPE IV AND FHWA CLASS VII RIPRAP
END NATIVE CHANNEL MATERIAL
END GRUBBING MATERIAL

15+38

SCALE 1" = 10'-0"
10 0 10

ECI ENGINEERS CONSTRUCTION
DuBois & King INC.

PROJECT NAME: RYEGATE	
PROJECT NUMBER: STP CULV(10)	
FILE NAME: z06c156chxs.dgn	PLOT DATE: 3/23/16
PROJECT LEADER: E. DETRICK	DRAWN BY: R. BARNES
DESIGNED BY: R. BARNES	CHECKED BY: E. DETRICK
CHANNEL CROSS SECTIONS 6 OF 6	SHEET 36 OF 36