SOIL NAIL WITH PLATE

TIEBACK OR SOIL NAIL WITH WALER BEAM OR BRACKET

TEST SOIL NAIL

5"STEEL LAGGING OR 3" WOOD LAGGING OR SHOTCRETE } SEE WP 3.4.4 AMENDMENT 2

HP12x53 SOLDIER PILE

GENERAL NOTES:

1. ACTUAL AS-BUILT CONDITION OF WALL IS SHOWN FROM APPROX. STA 6+00 TO STA 7+00 BECAUSE NOT ALL SHEETS ARE BELOW BOTTOM OF EXCAVATION. OUTSIDE THIS AREA SHEETS ARE SUFFICIENTLY EMBEDDED AND ARE SHOWN AS DESIGNED.
2. PATCH-WORK WALL SECTIONS ARE SHOWN TO ILLUSTRATE TIEBACK DETAILS ONLY. ACTUAL WALL DESIGN IS PROVIDED IN WP3.4.4.
3. TOE TIES NOT SHOWN FOR CLARITY.

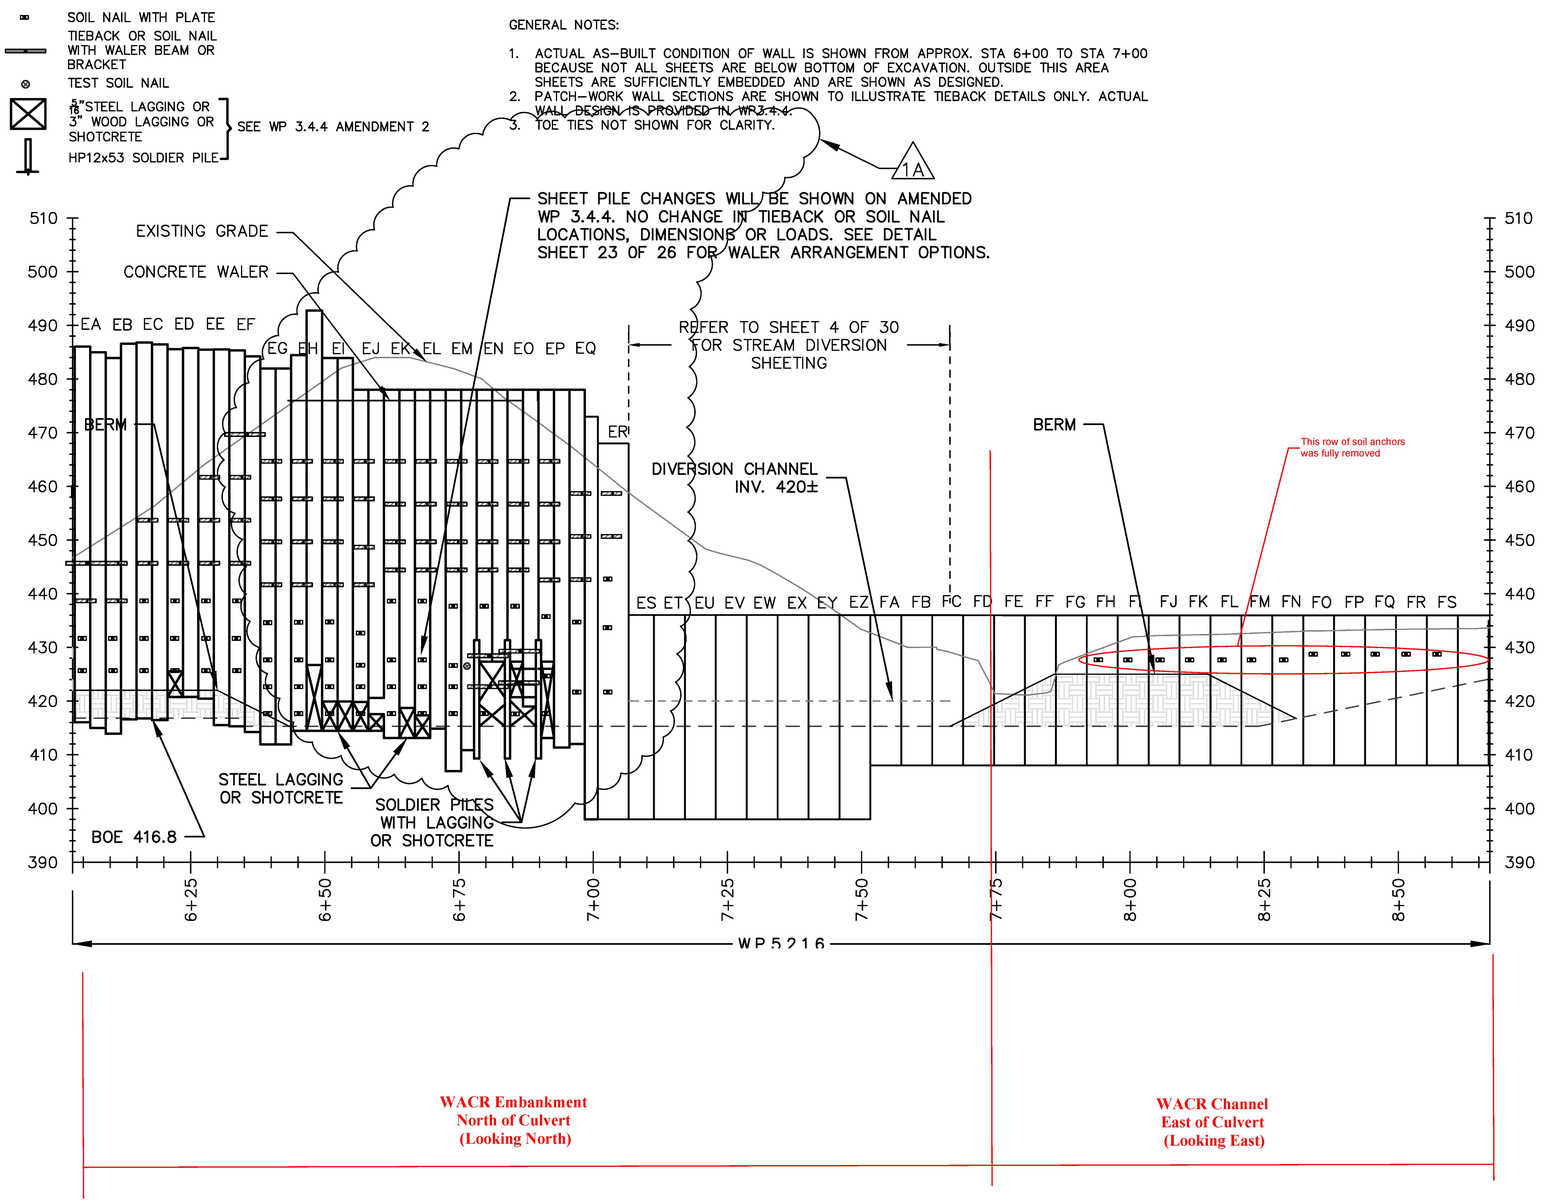

WACR Embankment North of Culvert (Looking North)

WACR Channel East of Culvert (Looking East)

(For Reference Only)

- Wales and Soil Anchor Heads Removed
- Sheet Piles Removed Except As Shown In Plan View

PROJECT NAME:	RYEGATE
PROJECT NUMBER:	STP CULV(10)
FILE NAME:	PLOT DATE:
PROJECT LEADER:	DRAWN BY:
DESIGNED BY:	CHECKED BY:
Abandoned Structures	SHEET 6 OF 8