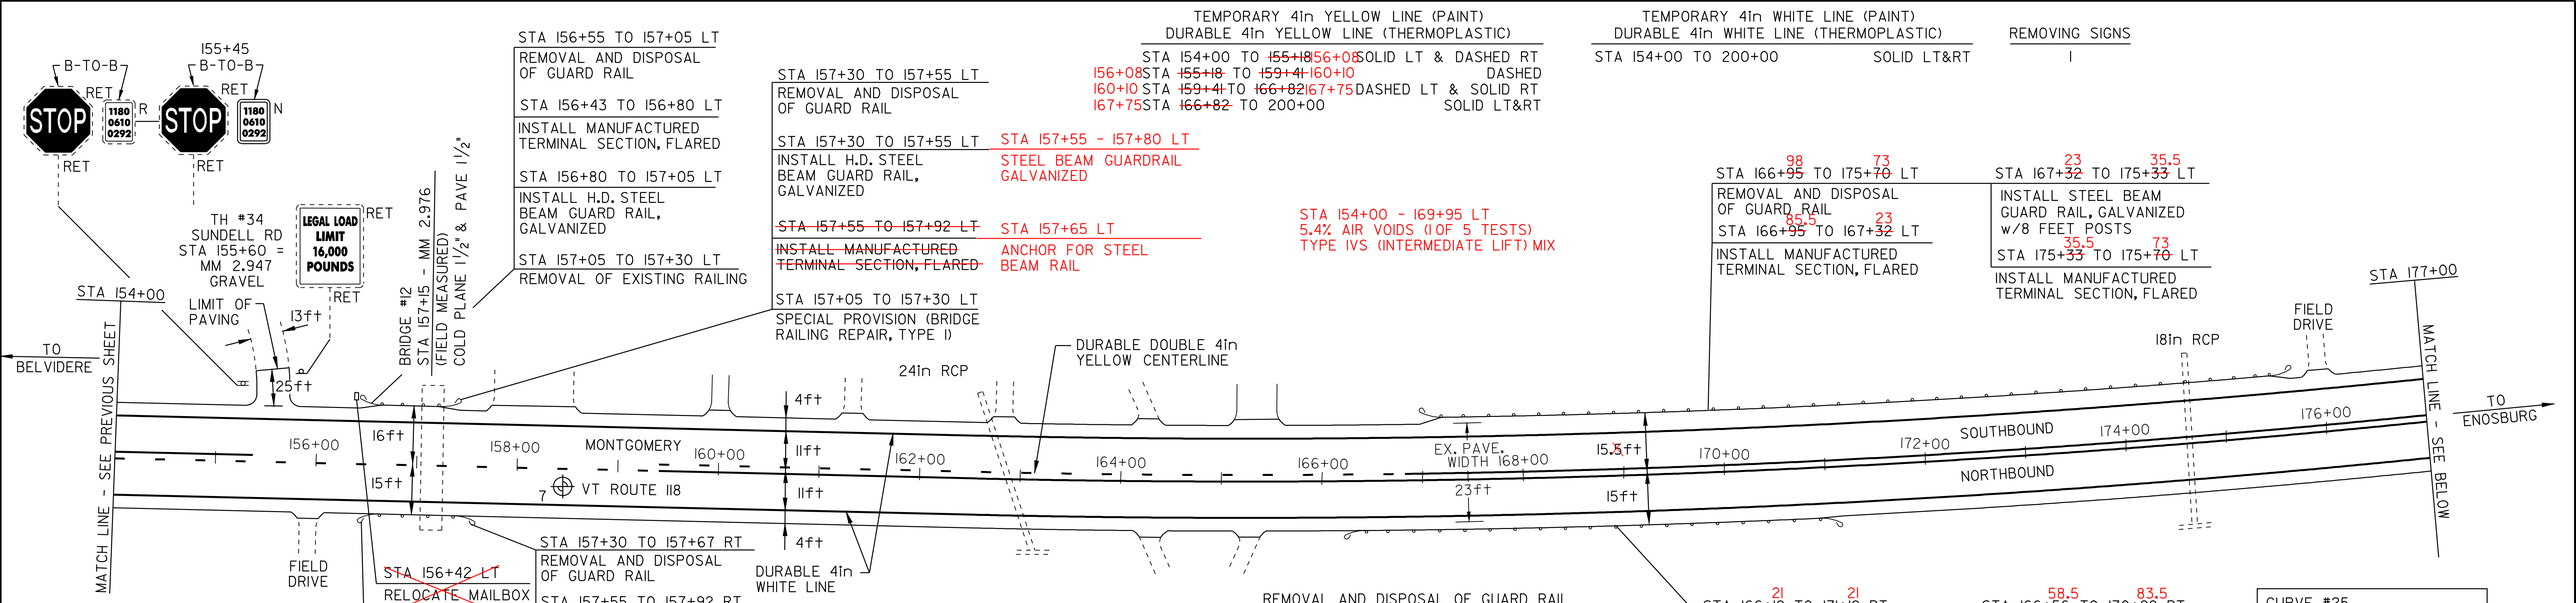

PAVEMENT CORES -

#	TOTAL DEPTH (in)	SOLID CORE	DRAINABLE BASE	COMMENTS
7	3.0	NO	NO	RUTTING IN RIGHT LANE

NOTE:
- NO PCC UNDER ANY CORES
- NO CORES OVER ASPHALTED
- NO SHOULDER CORES

PAVING PROJECT LAYOUT SHEET #7

DESIGNED BY BCE/PJM DATE 6-07
DRAWN BY C.E.A., INC. DATE 6-07
DESIGN FILE NO. p06cl62.dgn
PRF FILE p06cl62ppl7.i DATE PLOTTED 03-NOV-2009
PROJ. NAME **BELVIDERE - MONTGOMERY**
PROJ. NO. **STP 2619(1)S**
SHEET **15** OF **33** SHEETS