INDEX OF SHEETS
SEE SHEET 2

STATE OF VERMONT
AGENCY OF TRANSPORTATION

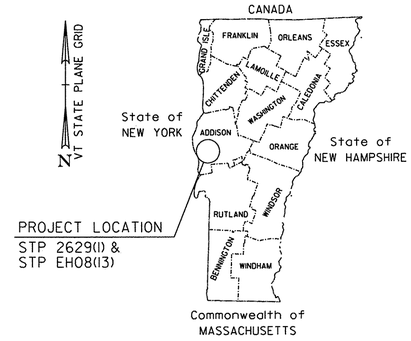

PROPOSED IMPROVEMENT
TOWNS OF WHITING, CORNWALL & MIDDLEBURY
COUNTY OF ADDISON
VT. ROUTE 30

WHITING-MIDDLEBURY
STP 2629(1)
SEE SHEET 6
FOR ADDITIONAL PROJECT INFORMATION
AND THE SUPERPAVE DESIGN CRITERIA

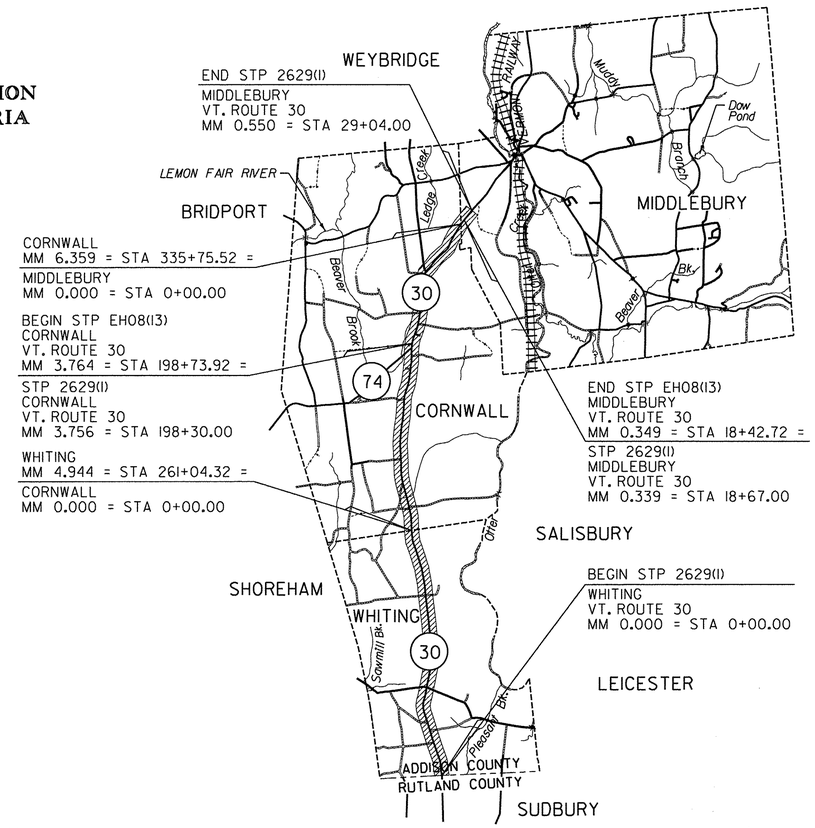

CORNWALL - MIDDLEBURY
STP EH08(13)
SEE SHEET 54
FOR ADDITIONAL PROJECT INFORMATION
AND PROPOSED SHOULDER GRADING

STATE OF VERMONT
RODNEY A. BASCOM
No. 6581
REGISTERED PROFESSIONAL ENGINEER

PLANS PREPARED BY

CHA

STATE OF VERMONT
MARK C. SMITH
NO. 6526
REGISTERED PROFESSIONAL ENGINEER

RSG, Inc.

RECORD PLANS

CONTRACTOR:	PIKE INDUSTRIES, INC. – BERLIN, VT
RESIDENT ENGINEER:	JOSH HULETT
CONSTRUCTION BEGAN:	AUGUST 30, 2010
CONSTRUCTION COMPLETE:	OCTOBER 10, 2010
RECORD PLANS BY:	JOSH HULETT & DARREN CONNOLLY

I HEREBY CERTIFY THAT ALL THE CONSTUCTION REQUIRED BY THIS SET OF DRAWINGS HAS BEEN ACCOMPLISHED AS INDICATED HEREIN.

BY Joshua P. Hulett RESIDENT ENGINEER

DATE March 21, 2012

NOTE: Any further information concerning final quantities, amounts or other details relative to this project may be found at Central Files in the electronic archives.

QUALITY ASSURANCE PROGRAM: LEVEL 3

CONVENTIONAL SYMBOLS

COUNTY LINE
TOWN LINE
LIMITS OF ACCESS
POINT OF ACCESS
FENCE LINE
STONE WALL
TRAVELED WAY
GUARD RAIL
RAILROAD
SURVEY LINE
CULVERT
POWER POLE
TELEPHONE POLE
TREES
CONTROL OF ACCESS
PROPERTY LINE
R.O.W. TAKING LINE
SLOPE RIGHTS SR SR SR
TOP OF CUT
TOE OF SLOPE

SURVEYED BY : NA
SURVEYED DATE : NA

DATUM
VERTICAL NA
HORIZONTAL NA

THESE PLANS ARE SUBJECT TO SUCH ENGINEERING CHANGES AS MAY BE REQUIRED BY THE FEDERAL HIGHWAY ADMINISTRATION OR THE DIRECTOR OF PROGRAM DEVELOPMENT.

CONSTRUCTION IS TO BE CARRIED ON IN ACCORDANCE WITH THESE PLANS AND THE STANDARD SPECIFICATIONS FOR CONSTRUCTION DATED 2006, AS APPROVED BY THE FEDERAL HIGHWAY ADMINISTRATION ON JUNE 15, 2006 FOR USE ON THIS PROJECT, INCLUDING ALL SUBSEQUENT REVISIONS AND SUCH REVISED SPECIFICATIONS AND SPECIAL PROVISIONS AS ARE INCORPORATED IN THESE PLANS.

DIRECTOR OF PROGRAM DEVELOPMENT
APPROVED Judith Johnson DATE 6-17-10

PROJECT MANAGER : MIKE FOWLER

PROJECT NAME : WHITING - MIDDLEBURY
CORNWALL - MIDDLEBURY

PROJECT NUMBER : STP 2629(1) & STP EH08(13)

SHEET 1 OF 133 SHEETS