LOCATION				FEET OF DITCHING				MISCELLANEOUS ITEMS		REMARKS
SITE	STATION	STATION	POS.	PERCENT GRADE				651.15 SEED	653.20 TEMP EROS MATT	
				0-1	1-2.5	2.5-10	>10			
VT. ROUTE 30								LB	SY	
WHITING:										
~~1~~	~~97+68~~	~~100+32~~	~~RT~~		~~264~~			2	117	
~~2~~	~~104+02~~	~~110+88~~	~~LT~~		~~686~~			5	305	
~~3~~	~~108+77~~	~~139+92~~	~~RT~~		~~3115~~			23	1385	
~~4~~	~~142+56~~	~~147+84~~	~~RT~~		~~528~~			4	235	
~~5~~	~~179+52~~	~~184+80~~	~~RT~~		~~528~~			4	235	
~~6~~	~~198+00~~	~~205+92~~	~~RT~~		~~792~~			6	352	
~~7~~	~~256+08~~	~~259+25~~	~~RT~~		~~317~~			2	141	
CORNWALL:										
~~8~~	~~5+28~~	~~10+56~~	~~RT~~		~~528~~			4	235	
	312+50	312+96			46					
	0+10	191+50			19140					
	4+72	54+00			4928					
	0+00	81+49			8149					
	81+81	116+14			3433					
	123+81	174+90			5109					
	206+00	214+00			800					
	282+00	289+00			700					
	282+00	311+00			2900					
	313+50	316+00			250					
	220+00	229+00			900					
	218+00	238+00			2000					
	257+00	273+00			1600					
	231+00	254+00			2800					
SUBTOTAL					~~6758~~			50	3005	
ROUNDINGS					~~42~~			-	-	
TOTALS					~~6800~~			50	3005	
					52820					

LOCATION				FEET OF DITCHING				MISCELLANEOUS ITEMS		REMARKS
SITE	STATION	STATION	POS.	PERCENT GRADE				651.15 SEED	653.20 TEMP EROS MATT	
				0-1	1-2.5	2.5-10	>10			
								LB	SY	
W	0+00	75+00	LT		7500					
W	164+34	226+35	LT		6201					
W	20+00	75+00	RT		5500					
W	120+00	W165+00	RT		4500					
W	86+00	116+70	LT		3070					
W	251+91	261+04	LT		913					
W	150+00	164+34	LT		1434					
M	15+67	27+91	RT		1224					
M	3+00	26+00	LT		2300					
					32642					
				TOTAL	85462					

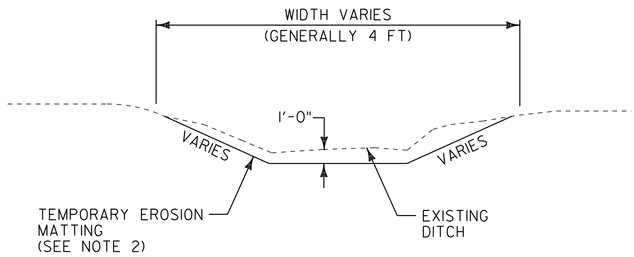

DITCH DETAIL

NOTES:

1. PIPE INLET AND OUTLET AREAS AND DITCH CLEANING THROUGHOUT THE PROJECT SHALL BE PERFORMED AT LOCATIONS IDENTIFIED ON THIS SHEET AND AS DIRECTED BY THE RESIDENT ENGINEER. PAYMENT WILL BE UNDER THE APPLICABLE EQUIPMENT RENTAL ITEM(S).
2. ESTIMATED QUANTITIES OF TEMPORARY EROSION MATTING AND SEED HAVE BEEN INCLUDED AS NEEDED OR AS DIRECTED BY THE RESIDENT ENGINEER.

NOT TO SCALE

DITCH CLEANING DETAIL SHEET

PROJECT NAME: WHITING - MIDDLEBURY

PROJECT NUMBER: STP 2629(I)

FILE NAME: p06c226.dgn
PROJECT LEADER: D.E.G.
DESIGNED BY: M.J.L.
DWG. NO. p06c226dcd.i

PLOT DATE: 30-MAR-2012 14:13
DRAWN BY: C.A.K.
CHECKED BY: D.E.G.
SHEET 16 OF 133