TEMPORARY 4" WHITE LINE, PAINT
DURABLE 4" WHITE LINE, RECESSED POLYUREA

150+50 TO 156+00 SOLID LT
150+50 TO 154+25 SOLID RT
155+18 TO 156+00 SOLID RT

TEMPORARY 4" WHITE LINE, PAINT
DURABLE 4" WHITE LINE, THERMOPLASTIC

154+25 TO 154+46 SOLID RT (TH 356)
155+18 TO 156+00 SOLID RT (TH 356)

TEMPORARY 4" YELLOW LINE, PAINT
DURABLE 4" YELLOW LINE, RECESSED POLYUREA

150+50 TO 154+38 SOLID LT & RT
155+01 TO 156+00 SOLID LT & RT

TEMPORARY 4" YELLOW LINE, PAINT
DURABLE 4" YELLOW LINE, THERMOPLASTIC

154+64 DOUBLE SOLID RT (TH 356)

TEMPORARY LETTER OR SYMBOL, PAINT
DURABLE LETTER OR SYMBOL, THERMOPLASTIC

154+78 RT - STOP (TH 356)

TEMPORARY 24" STOP BAR, PAINT
DURABLE 24" STOP BAR, RECESSED TYPE I TAPE

154+66 TO 155+01 RT

ADJUST ELEVATION
OF VALVE BOX

154+44 LT
154+48 LT
154+50 RT (TH 356)

REHAB. DROP INLETS, CATCH BASINS,
OR MANHOLES, CLASS I, II, OR III

150+51 LT (CB)
151+18 RT (CB)
151+52 LT (CB)
151+91 RT (CB)
153+83 LT (CB)
154+53 RT (CB)
155+06 RT (CB)
155+38 LT (CB)

CHANGING ELEVATION
OF SEWER MANHOLES

154+78 RT

REMOVING SIGNS

AS SHOWN - 4

ERECTING SALVAGED SIGNS

AS SHOWN - 3

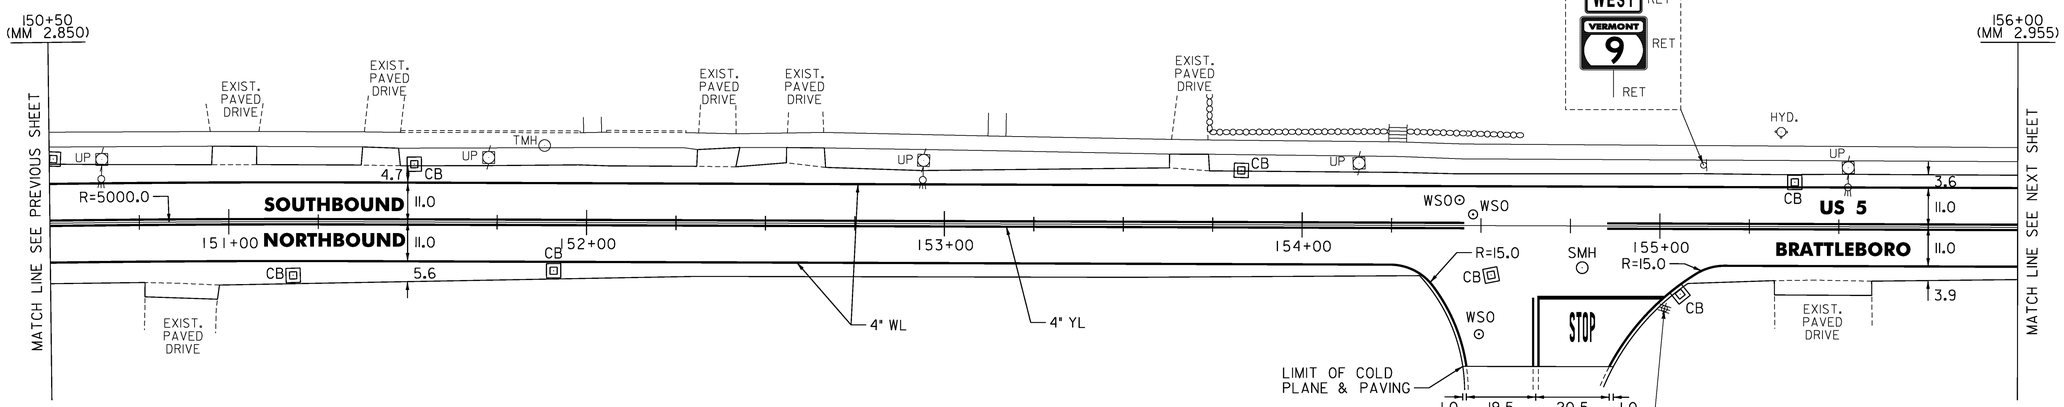

NOT TO SCALE

LEGEND

R	=	REMOVE EXISTING
S	=	SALVAGE
R&S	=	REMOVE AND SALVAGE
N	=	NEW
RET	=	RETAIN
B-B	=	BACK TO BACK
	=	EXISTING GUARDRAIL
	=	PROPOSED GUARDRAIL
YL	=	YELLOW LINE
WL	=	WHITE LINE

ROADWAY LAYOUT 24 US 5

PROJECT NAME: BRATTLEBORO
PROJECT NUMBER: STP 2623(I)

FILE NAME: /pave/06d214/pd214
PROJECT LEADER: PTS
DESIGNED BY: NLL
IPARM FILE NAME: 06D214_50

PLOT DATE: 3/19/2010
DRAWN BY: MRS
CHECKED BY: PTS
SHEET 50 OF 163

MODEL: Default

CLD 08-0324 z06D0214.dgn