TEMPORARY 4" YELLOW LINE, PAINT
DURABLE 4" YELLOW LINE, THERMOPLASTIC
1+00 TO 6+00 SOLID LT & RT

TEMPORARY 4" WHITE LINE, PAINT
DURABLE 4" WHITE LINE, THERMOPLASTIC
1+00 TO 2+25 SOLID LT (TH 334)
1+00 TO 6+00 SOLID RT
2+31 TO 6+00 SOLID LT (TH 334)

TEMPORARY 24" STOP BAR, PAINT
DURABLE 24" STOP BAR, RECESSED TYPE I TAPE
1+96 TO 2+01 LT

TEMPORARY LETTER OR SYMBOL, PAINT
DURABLE LETTER OR SYMBOL, THERMOPLASTIC
2+02 LT - STOP (TH 334)
2+42 LT - AHEAD
2+90 LT - STOP

REHAB. DROP INLETS, CATCH BASINS,
OR MANHOLES, CLASS I, II, OR III
2+00 LT (CB) (TH 334)
2+13 RT (CB)
2+22 LT (CB) (TH 334)
5+47 LT (CB)

THINNING AND TRIMMING FOR SIGNS
(SEE DETAIL ON SHEET 10)
~~2+60 LT~~
~~3+40 LT~~
~~3+80 LT~~

ADJUST ELEVATION
OF VALVE BOX
1+65 LT

REMOVING SIGNS
AS SHOWN - 20

ERECTING SALVAGED SIGNS
AS SHOWN - 2

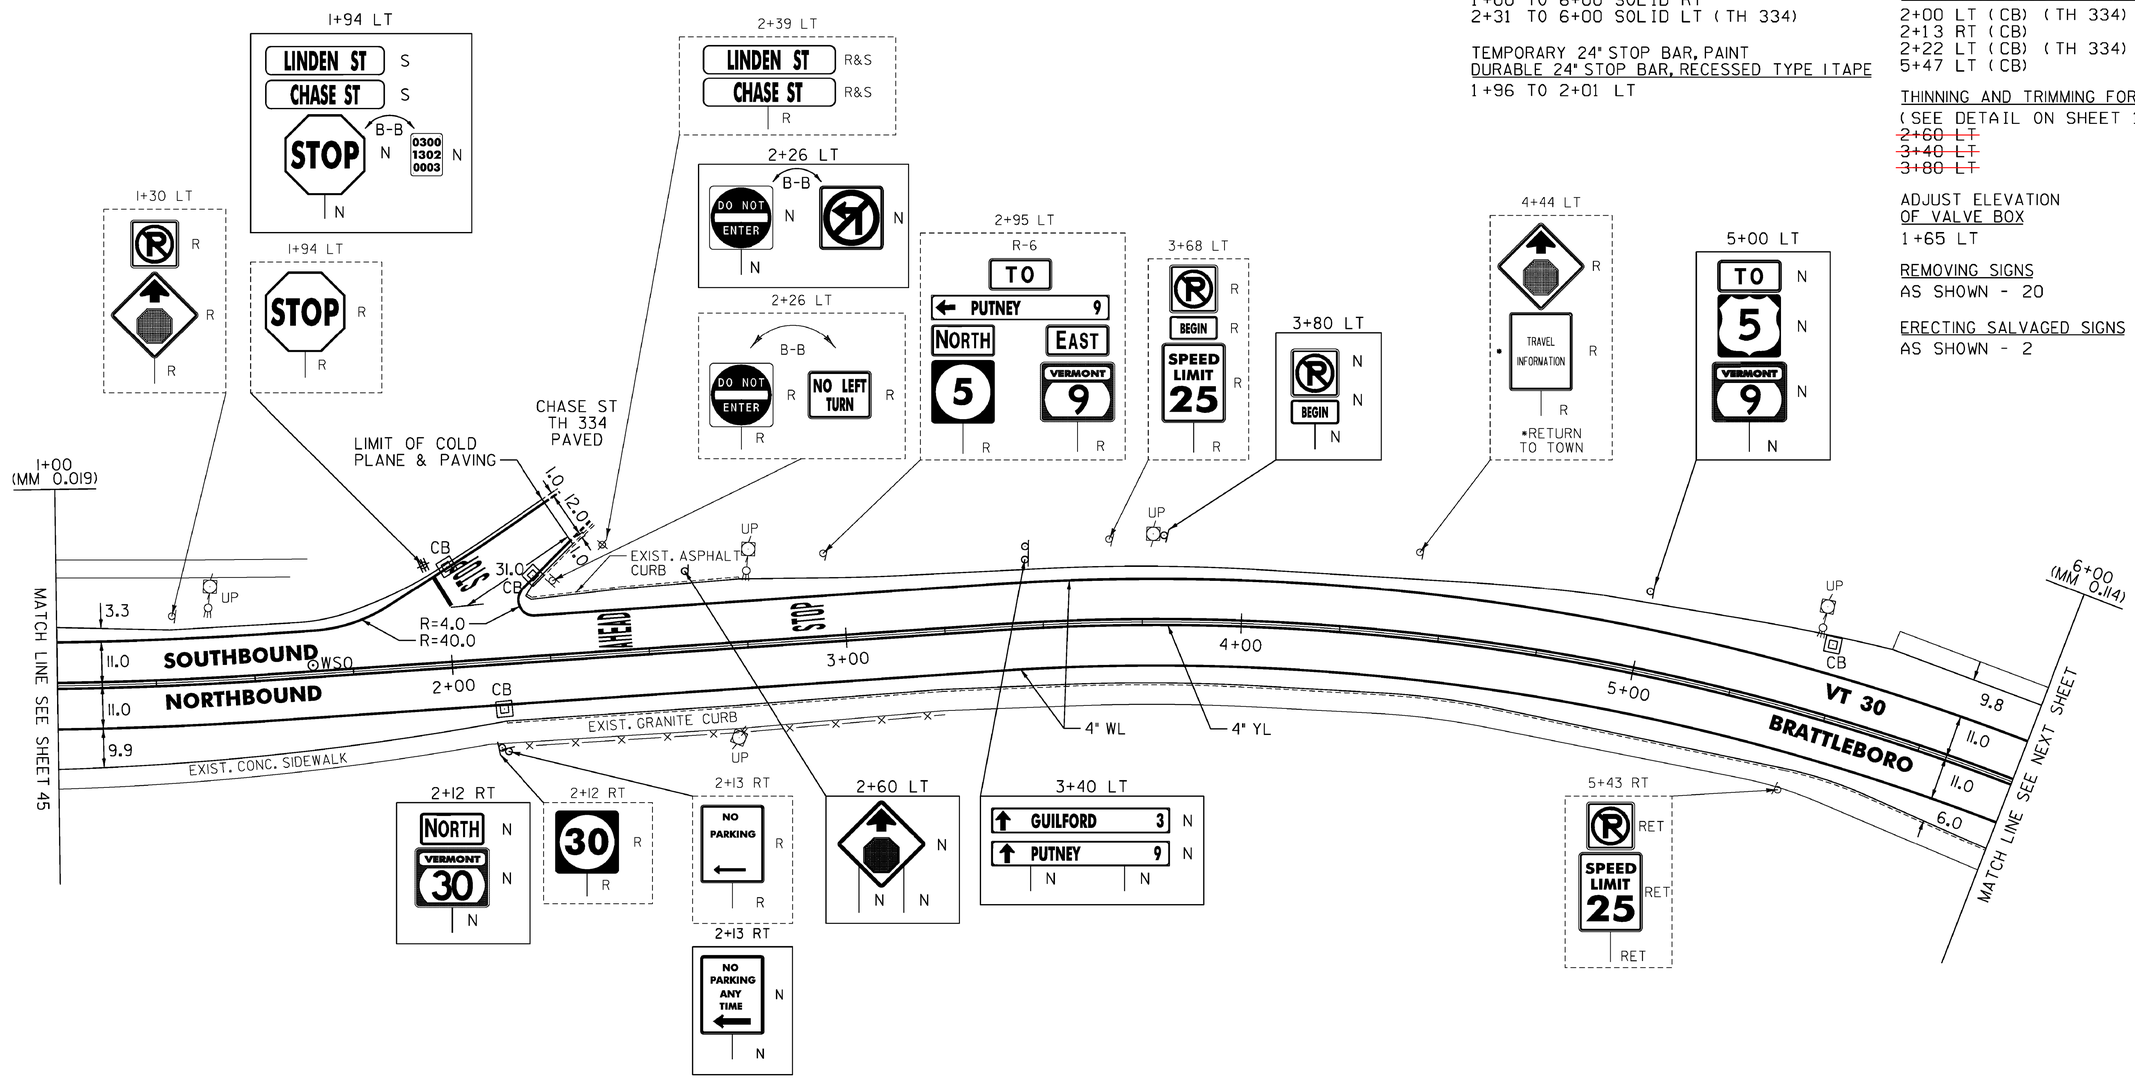

LEGEND

R	=	REMOVE EXISTING
S	=	SALVAGE
R&S	=	REMOVE AND SALVAGE
N	=	NEW
RET	=	RETAIN
B-B	=	BACK TO BACK
	=	EXISTING GUARDRAIL
	=	PROPOSED GUARDRAIL
YL	=	YELLOW LINE
WL	=	WHITE LINE

NOT TO SCALE

ROADWAY LAYOUT 37 VT 30

PROJECT NAME: BRATTLEBORO
PROJECT NUMBER: STP 2623(I)

FILE NAME: /pave/06d214/pd214
PROJECT LEADER: PTS
DESIGNED BY: NLL
IPARM FILE NAME: 06D214_63

PLOT DATE: 3/19/2010
DRAWN BY: MRS
CHECKED BY: PTS
SHEET 63 OF 163

MODEL: Default

CLD 08-0324 z06D0214.dgn