


**SIGN LEGEND**

- EXISTING SIGN
- NEW SIGN
- R = REMOVE EXISTING SIGN AND POST
- R+S = SALVAGE SIGN AND RELOCATE TO NOTED LOCATION WITH NEW SIGN POST, REMOVE AND DISPOSE EXISTING SIGN POST
- N = NEW
- RET = RETAIN AT EXISTING LOCATION
- B-B = BACK TO BACK

**NOTE:**

- REFER TO TRAFFIC SIGNAL SHEETS FOR THE SIGNS ASSOCIATED WITH SIGNALS.
- PAVEMENT MARKINGS ARE TO BE COMPLETED UNDER CONTRACT STP 2623(I) AND ARE SHOWN FOR REFERENCE ONLY ON THESE PLANS.

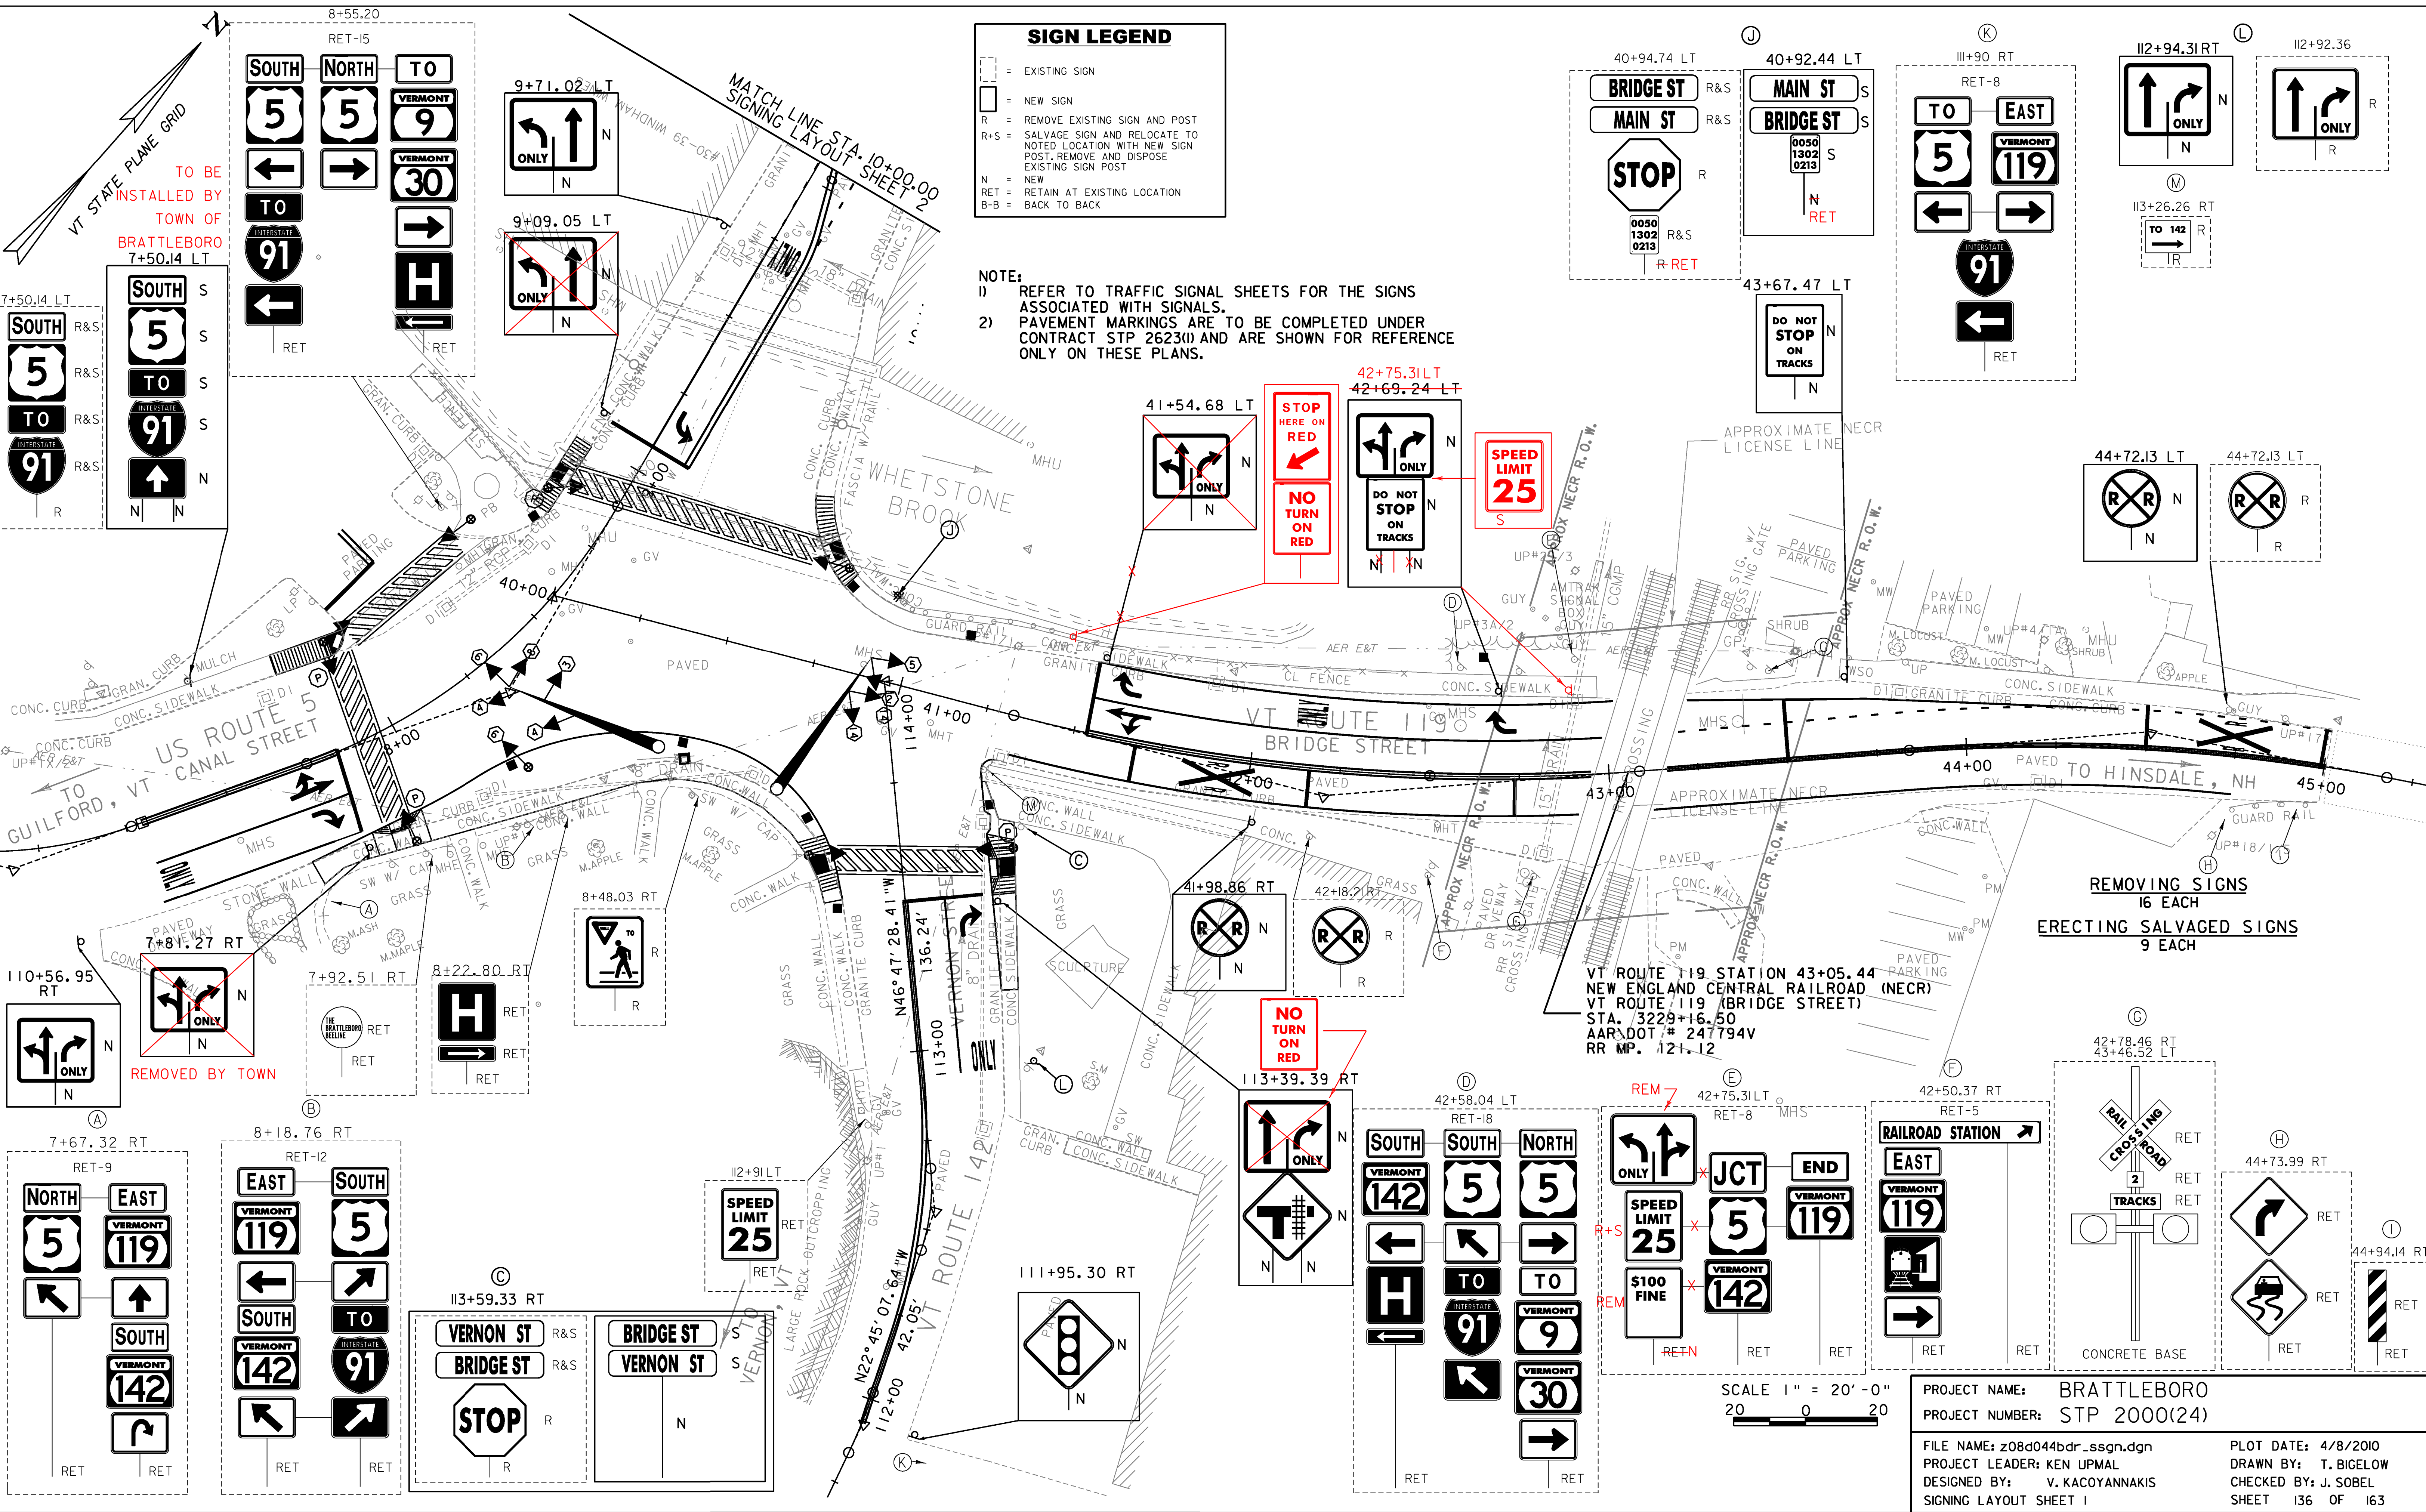

PROJECT NAME: BRATTLEBORO  
 PROJECT NUMBER: STP 2000(24)  
 FILE NAME: z08d044bdr\_ssgn.dgn  
 PROJECT LEADER: KEN UPMAL  
 DESIGNED BY: V. KACOYANNAKIS  
 SIGNING LAYOUT SHEET 1

PLOT DATE: 4/8/2010  
 DRAWN BY: T. BIGELOW  
 CHECKED BY: J. SOBEL  
 SHEET 136 OF 163