FOR ALL CONSTRUCTION NOTES SEE SHEET 25

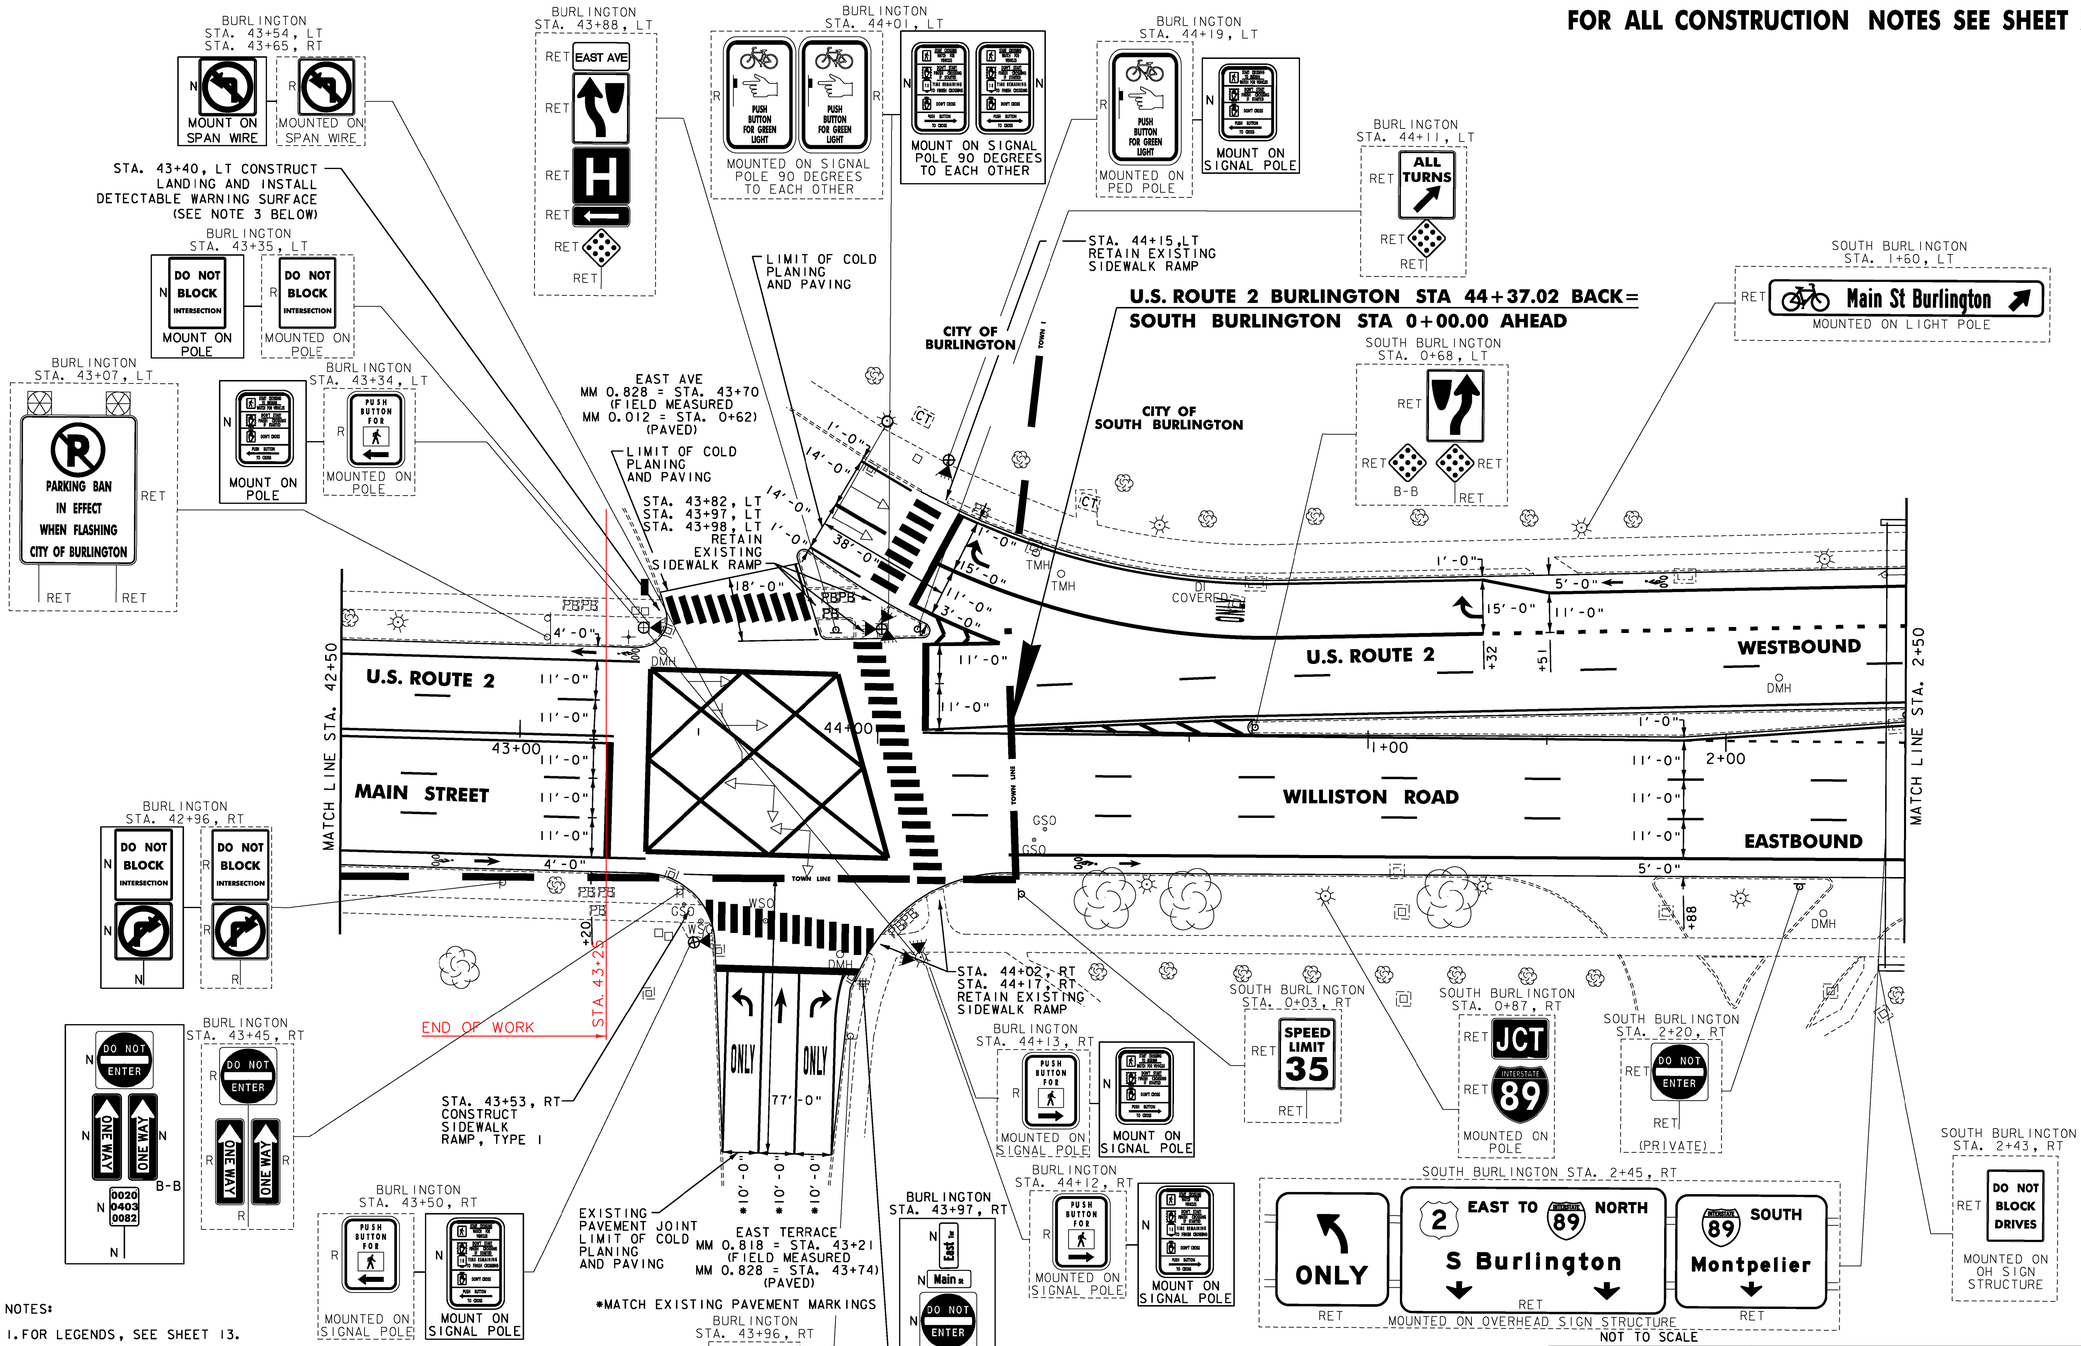

NOTES:

1. FOR LEGENDS, SEE SHEET 13.
2. ALL EXISTING SIGNS NOT SHOWN SHALL BE RETAINED.
3. THE SIDEWALK "LANDINGS" NOTED CONSIST OF REMOVAL OF EXISTING CONCRETE AND SIDEWALK AS SHOWN AND REPLACING IT WITH NEW SUBBASE, CONCRETE AND DETECTABLE WARNING SURFACE.
4. SEE SHEET 99 FOR TRAFFIC SIGNAL DETAILS.

Stantec

PROJECT LAYOUT SHEET #12A

PROJECT NAME: BURLINGTON-SOUTH BURLINGTON	
PROJECT NUMBER: NH 2624(I)	
FILE NAME: p06d216.dgn	PLOT DATE: 2/7/2012
PROJECT LEADER: JLL	DRAWN BY: STANTEC
DESIGNED BY: STANTEC	CHECKED BY: STANTEC
IPARM FILE: p06d216I12A.i	SHEET 24 OF 108